

Coahoma  
L 29  
7-66

MISSISSIPPI BOARD OF WATER COMMISSIONERS  
Elev. 157

GW 5911 NE/4SW, Sec. 35,  
T26N, R4W

WATER WELL DRILLERS LOG

**CODED**

Date: 7-8, 1966, Driller: Five County Farmers Assn County, Coahoma  
(Name)

(1) Owner of Land: Parlety Co  
(Name)  
Rt-2 Clarkdale Miss  
(Address)

(2) Location: NE 1/4, SW 1/4, Sec. 35 T26N R4W  
8 miles SE, of Clarkdale  
(distance) (direction) (Nearest Town)

(3) Topography: Flat  
(Hilly) (Flat) (Level)

(4) Purpose of Well: Irrigation  
(Domestic, Irrigation, Municipal, Industrial, Other)

Description & Color of Materials Sand, Clay, Red Clay, Shell, etc.	Thick- ness Feet	Depth Feet
Clay		40'
Sand	13	53'
Sand + Gravel	32 1/2	85 1/2'
Sand, Gravel & Trace of clay	6 1/2	92'
Sand, Gravel + large rock	26'	113'

Information upon completion of well:

(1) Diameter 6" inches.

(2) Total Depth 109' feet.

(3) Water Level 13' 9" feet below top of ground.

(4) Cased to 61', Size 6".

(5) Screen: Size 6", Length 48'.


(6) Were any formations sealed against pollution?  
 yes,  no.

If YES depth of formation \_\_\_\_\_

Why \_\_\_\_\_

Drillers Remarks: \_\_\_\_\_

**CODED**

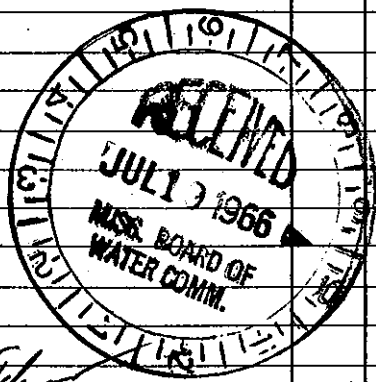

*[Signature]*

(Use Back Side)

Well No.

Mail this copy to Board of Water Commissioners 429 Miss. St. Jackson, Miss.