

Coahoma  
 L 30-32  
 7-67

MISSISSIPPI  
 BOARD OF WATER COMMISSIONERS  
 416 North State Street  
 Jackson, Mississippi 39201

**CODED**

WATER WELL DRILLERS LOG

July 27 1967 FIVE COUNTY FARMERS ASSN Coahoma  
 date well completed firm name county well located


LANDOWNER: MARYLAND ATE CO  
CHARKSDALE  
MISS  
 (mailing address)

description of formations encountered	from	to
topsoil		14'
clay		40
sand		46'
coarse sand streak clay		53
coars. sand & gravel		127
clay		130
		131

WELL LOCATION:  
 sec. 11 T. 26N R. 4 W  
4 miles South Charkeville  
 (distance) (direction) (nearest town)

WELL PURPOSE: IRRIGATION  
 (home, irrigation, municipal, industrial)

WELL COMPLETION DATA:  
 (1) diameter (inches) 6"  
 (2) total depth (feet) 125'-7"  
 (3) static water level (feet) 23' below above top of ground.  
 (4) casing PIPE 77'  
 (material) (depth)  
6 if telescope see back.  
 (size)  
 (5) screen 48 77'  
 (length) (depth to top)  
6" Open 10'  
 (size) (material)  
 (6) pump 30 1000 gpm  
 (HP) (yield gpm)  
Chrysler  
 (type power)  
 (7) electric log NO  
 (yes or no)  
 (organization running log)  
 (8) how well bottom plugged welded

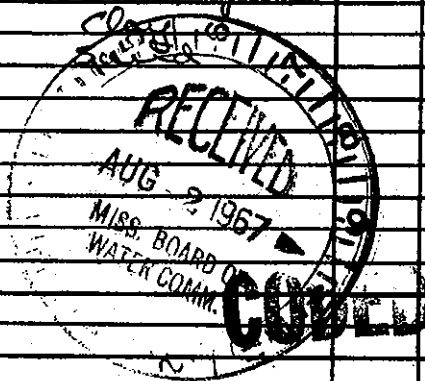

DRILLERS REMARKS: