

C17282
Well #1

COAHOMA
L33
2-9-74

MISSISSIPPI
BOARD OF WATER COMMISSIONERS
416 North State Street
Jackson, Mississippi 39201


CODED

WATER WELL DRILLERS LOG

February 9, 1974 Singer-Layne Central Div. Coahoma
date well completed firm name county well located

LANDOWNER:	description of formations encountered	from	to
Mascot Plantation			
Clarksdale, Mississippi (mailing address)	Fine Sand Clay Balls	36	45
	Coarse Pea Gravel	45	80
WELL LOCATION:	Gravel with small amount		
sec. 34 T. 26 N. R. 4 E. S. 3 W.	of Clay balls.	80	101
3 miles East of Alligator (distance) (direction) (nearest town)	Rock	101	
WELL PURPOSE: Irrigation (home, irrigation, municipal, industrial)			
WELL COMPLETION DATA:			
(1) diameter (Inches) 16"			
(2) total depth (feet) 101'			
(3) static water level (feet) 19 below top of ground.			
(4) casing Steel, 51' (material), (depth)			
16" (size) If telescope see back.			
(5) screen 50' (length), 101' (depth to top)			
16" (size), Armco Iron (material)			
(6) pump 60 (HP), 2800 (yield gpm)			
Engine (type power)			
(7) electric log No (yes or no)			
(organization running log)			
(8) how well bottom plugged Plate			
DRILLERS REMARKS:			

CODED

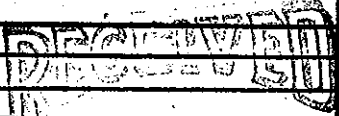

FEB 22 1974

MISS. BD. OF WATER COMM