

Coahoma
L57
3-13-81

MISSISSIPPI DEPARTMENT OF NATURAL RESOURCES
Bureau of Land and Water Resources
Southport Mall
P.O. Box 10631
Jackson, Mississippi 39209
Elev. 161 WATER WELL DRILLERS LOG

CODED

3-13 1981 Zue Co Drillers Coahoma
date well completed firm name county well located


LANDOWNER: Paul Koehn (K)
Clarksdale Miss
(mailing address)

description of formations encountered	from	to
<u>top soil</u>	<u>0</u>	<u>8</u>
<u>Clay</u>	<u>8</u>	<u>17</u>
<u>fine sand</u>	<u>17</u>	<u>34</u>
<u>mud sand</u>	<u>34</u>	<u>56</u>
<u>coarse sand</u>	<u>56</u>	<u>89</u>
<u>coarse sand & gra</u>	<u>89</u>	<u>110</u>

WELL LOCATION:
sec 25 T 26 N R 4 E
S W
3 miles west of Wilton
(distance) (direction) (nearest town)

WELL PURPOSE: Fish Pond
(home, irrigation, municipal, industrial)

- WELL COMPLETION DATA:
- (1) diameter (inches) 8"
 - (2) total depth (feet) 110'
 - (3) static water level (feet) 25 ^{below} _{above} top of ground.
 - (4) casing Pls. (material), 70 (depth)
8 (size) if telescope see back.
 - (5) screen 40' (length), 70' (depth to top)
8" (size), Pls (material)
 - (6) pump 10 (HP), 550 (yield gpm)
Elec (type power)
 - (7) electric log no (yes or no)
(organization running log)
 - (8) how well bottom plugged Cap

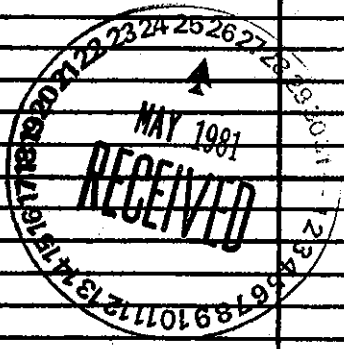

DRILLERS REMARKS: