Permit #: 6W 41/65 Office of Land	ent of Environmental Quality Aquifer:
Trrigation Equipment	and Water Resources Box 10631 Well #:
6-27-06 Jackson,	MS 39289-0631 L. S. Elevation:
Date drilling completed: (601)	1)961-5210 54-6938 (fax) E-log #:
State Law requires that this report be prepared by th 30 days of completion of drilling of the well.	e driller in detail and filed with the Department within
Well Owner Information	Well Location
Owner NameMascot Planting Company	Latitude: 34 Q4 39.1 Longitude: 90 35 1.1.6.
Mailing Address: 6850 New Africa Road	Method of Lat/Long (circle one): Conventional Survey,
	USGS quad, Hand-held GPS, Survey-grade GPS
Clarksdale MS 38614	NW 1/4 SW 1/4 Sec 35 Twn 26N Rng 4W
City State Zip Code	Distance Direction Nearest Town
•	7 Miles South of Clarksdale
Telephone No. ()	
Well	Data Gw-1199
Purpose of Well (circle one) Home Industrial Public Supply	Irrigation Fish Culture Other. Replace
Date well drilling started: 6-27-06 Date	well drilling completed:
If flowing, method of flow regulation: Valve Other (
Static Water Level: 45' feet above on below (circle one)	land markets Data markets 6-28-06
icet above ordelow (circle one)	iand surface Date measured:

Method of Measurement (circle one) steel tape electric tape	air line other:
Method of Measurement (circle one) steel tape electric tape Hole depth: 125 Well depth: 125	***************************************
Method of Measurement (circle one) steel tape electric tape	well grouted to a depth of 10 feet
Method of Measurement (circle one) steel tape electric tape Hole depth: 125 Well depth: 125 Type of grout (circle one): Cement Bentonite Mix	well grouted to a depth of 10 feet
Method of Measurement (circle one) steel tape electric tape Hole depth: 125 Well depth: 125	well grouted to a depth of 10 feet inches Type of casing: PVC Sch. 40
Method of Measurement (circle one) steel tape electric tape Hole depth: 125 Well depth: 125 Type of grout (circle one): Cement Bentonite Mix Casing length: 85 feet Casing diameter: 16 Screen length: 40 feet Screen diameter: 16	well grouted to a depth of 10 feet inches Type of casing: PVC Sch. 40 inches Type of screen: PVC Sch. 40
Method of Measurement (circle one) steel tape electric tape Hole depth: 125 Well depth: 125 Type of grout (circle one): Cement Bentonite Mix Casing length: 85 feet Casing diameter: 16 Screen length: 40 feet Screen diameter: 16 Screen slot size: .050 inches Setting depth: From	well grouted to a depth of 10 feet inches Type of casing: PVC Sch. 40 inches Type of screen: PVC Sch. 40 inches Type of screen: PVC Sch. 40 inches feet to 125 feet
Method of Measurement (circle one) steel tape electric tape Hole depth: 125 Well depth: 125 Type of grout (circle one): Cement Bentonite Mix Casing length: 85 feet Casing diameter: 16 Screen length: 40 feet Screen diameter: 16 Screen slot size: .050 inches Setting depth: From	well grouted to a depth of 10 feet inches Type of casing: PVC Sch. 40 inches Type of screen: PVC Sch. 40
Method of Measurement (circle one) steel tape electric tape Hole depth: 125 Well depth: 125 Type of grout (circle one): Cement Bentonite Mix Casing length: 85 feet Casing diameter: 16 Screen length: 40 feet Screen diameter: 16 Screen slot size: .050 inches Setting depth: From	well grouted to a depth of 10 feet inches Type of casing: PVC Sch. 40 inches Type of screen: PVC Sch. 40 inches Type of screen: PVC Sch. 40 inches feet to 125 feet
Method of Measurement (circle one) steel tape electric tape Hole depth: 125 Well depth: 125 Type of grout (circle one): Cement Bentonite Mix Casing length: 85 feet Casing diameter: 16 Screen length: 40 feet Screen diameter: 16 Screen slot size:	well grouted to a depth of 10 feet inches Type of casing: PVC Sch. 40 inches Type of screen: PVC Sch. 40 inches Type of screen: PVC Sch. 40 inches feet to 125 feet
Method of Measurement (circle one) seel tape electric tape Hole depth: 125 Well depth: 125 Type of grout (circle one): Cement Bentonite Mix Casing length: 85 feet Casing diameter: 16 Screen length: 40 feet Screen diameter: 16 Screen slot size:	Well grouted to a depth of
Method of Measurement (circle one) Hole depth: 125 Type of grout (circle one): Cement Casing length: 85 feet Casing diameter: 16 Screen length: 40 feet Screen diameter: 16 Screen slot size: 5050 Type of completion (circle all applicable): Gravel packed Under Other (describe): 16 Logs run (circle all applicable): No log run Electric Gamma Ray Name of organization running log(s):	Well grouted to a depth of
Method of Measurement (circle one) steel tape electric tape Hole depth: 125 Well depth: 125 Type of grout (circle one): Cement Bentonite Mix Casing length: 85 feet Casing diameter: 16 Screen length: 40 feet Screen diameter: 16 Screen slot size: 050 inches Setting depth: From Type of completion (circle all applicable): Gravel packed Under Other (describe): Top of lap pipe or reduction in casing: feet. If tee Logs run (circle all applicable): No log run Electric Gamma Ray Name of organization running log(s): I certify that the well was drilled, constructed, and completed in	well grouted to a depth of
Method of Measurement (circle one) Hole depth: 125 Well depth: 125 Type of grout (circle one): Cement Bentonite Mix Casing length: 85 feet Casing diameter: 16 Screen length: 40 feet Screen diameter: 16 Screen slot size: 050 inches Setting depth: From Type of completion (circle all applicable): Gravel packed Under Other (describe): Top of lap pipe or reduction in casing: feet. If te Logs run (circle all applicable): No log)run Electric Gamma Ray Name of organization running log(s): I certify that the well was drilled, constructed, and completed in Department of Environmental Quality and/or the Mississippi De	well grouted to a depth of
Method of Measurement (circle one) Hole depth: 125 Well depth: 125 Type of grout (circle one): Cement Bentonite Mix Casing length: 85 feet Casing diameter: 16 Screen length: 40 feet Screen diameter: 16 Screen slot size:	well grouted to a depth of
Method of Measurement (circle one) Hole depth: 125 Well depth: 125 Type of grout (circle one): Cement Bentonite Mix Casing length: 85 feet Casing diameter: 16 Screen length: 40 feet Screen diameter: 16 Screen slot size:	well grouted to a depth of

State Well Report

Part 1

Coahoma

JUL 1 0 2006

For Office Use Only:

County: Coahoma Permit #: 6 4 4 6 5 Irrigation Equipment Driller: 6-27-06 Date drilling completed: 6-27-06 PMississippi Department Office of Land a P.O. F. Jackson, M. (601)	For Office Use Only: Aquifer:			
State Law requires that this report be prepared by the 30 days of completion of drilling of the well.	driller in detail and filed with the Department within			
Well Owner Information Owner Name Mascot Planting Company Mailing Address: 6850 New Africa Road	Well Location Latitude: 34 Q4 39.1 Longitude: 17.			
Mailing Address: Hew Allica Road	Method of Lat/Long (circle one): Conventional Survey,			
	USGS quad, Hand-held GPS, Survey-grade GPS			
Clarksdale MS 38614	NW 1/4 SW 1/4 Sec 35 Twn 26N Rng 4W			
City State Zip Code Distance Direction Nearest Town 7 Miles South of Clarksdale Telephone No. ()				
Well I	Data GW 11997			
Purpose of Well (circle one) Home Industrial Public Supply Irrigation Fish Culture Other: Date well drilling started: Date well drilling completed:				
If flowing, method of flow regulation: Valve Other (de	escribe)			
Static Water Level: 45' feet above on below (circle one) le	and surface Date measured: $6-28-06$			
Method of Measurement (circle one) seel tape electric tape	air line other:			
Hole depth: 125 Well depth: 125 Well grouted to a depth of 10 feet				
Type of grout (circle one): Cement Bentonite Mix				
Casing length: 85 feet Casing diameter: 16 inches Type of casing: PVC Sch. 40				
	_inches Type of screen: PVC Sch. 40			
Screen slot size:				
Type of completion (circle all applicable): Gravel packed Underreamed Telescoped Open hole Natural Development Other (describe):				
Top of lap pipe or reduction in casing:feet. If telescoped or more than one screen, describe on back of page				
Logs run (circle all applicable): (No log run Electric Gamma Ray Density Sonic Neutron Other:				
Name of organization running log(s): I certify that the well was drilled, constructed, and completed in accordance with all applicable requirements of the Mississippi				
1 ceruity that the well was drilled, constructed, and completed in accordance with all applicable requirements of the Mississippi Department of Environmental Quality and/or the Mississippi Department of Health regulations and state laws				

Irrigation Equipment Inc. Patrick M. Chism 0695

Print Name of Water Well Contractor and License No.

RECEIVED
JUL 10 2006
BY CALVANT

Signature of Water Well Contractor


Ground Level

Old well 80' South

Description of Formations Encountered	From	То
Clay	0	51
Fine Sand/gravel	52	60
Med. Sand/gravel	61	71
1 (1)	72	78
Med. Sand/gravel	79	125
		<u> </u>
	ļ	
		<u> </u>
	ļ	
	ļ	
	<u> </u>	
	ļ	
		ļ
	ļ. —	-
	ļ	<u></u>
	 	<u> </u>
	<u> </u>	ļ
	ļ. ——	<u> </u>
	 	<u> </u>
		<u> </u>
	1	<u> </u>

If more than one screen, show location of each on sketch

Sketch the property layout and include the following: 1) the well location; 2) any permanent structures on the property that may aid in locating the well; 3) any roads, power lines, or other items that may aid in locating the property and the well; 4) indicate direction.

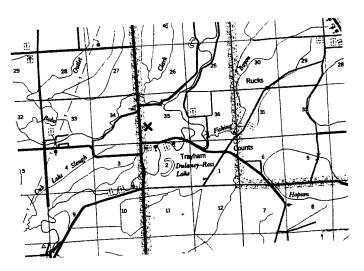

Landowner Name:	

Signature of Water Well Contractor

STATE WELL REPORT

County: Coahoma Permit#: 649 411 65 Irrigation Equipment Driller: 6-27-06

Part 2
Pump Installer's Completion Report
Mississippi Department of Environmental Quality
Office of Land and Water Resources
P.O. Box 10631
Jackson, MS 39289-0631
(601)961-5210

For Office Use Only:		
Aquifer:	•	
Well #: _	1-94	
Elevation:		

Copy information from block on Part 1	(601)35	4-6938 (fax)	Elevation:	
This part of the report must be complete report must be attached and both parts f	— d by a licensed water well of filed with the Department of	contractor or a licensed at the above address with	pump installer. A copy	of Part 1 of the pletion.
Well Owner Inform			Well Location	
Owner Name: Mascot Plant	ing Company	Latitude:	Longitude:	
Mailing Address: 6850 New A	frica Road	Method of Lat/Long (check one): Conventional Survey,		
		USGS quad, Ha	and-held GPS, Surv	ey-grade GPS
	MS 38614	NW 1/4 SW 1/4	Sec_35 T_26N	R 4W
City State	Zip Code	1	ection Nearest To	
Telephone No. ()	·	7 Miles Sc	outh Clarks	sdale
Pump Type Circle one			Power Type Circle one	
Air Lift Jet	Submersible	Qiesel Engine	Gasoline Engine	Natural Gas
Bucket Piston	Turbine	Electric Motor	Hand	Tractor PTO
Centrifugal Rotary	Flowing Well	· ·	Other (specify):	
Other (specify):		Horse Power Rating of	of Motor: 60	
Date Pump installed: $\frac{6-28-06}{2500-3000}$		Setting Depth:		feet
Rated Pump Capacity:	_Gallons Per Minute	Number of Stages:		_
Pump Test Date	Method of Measuring Water Level Circle one			
Date Well Tested:		Airring Fire		Steel Tape
Static Water Level (A):Fe	et Below Land Surface		tric Measuring Line	•
Pumping Water Level (B):Fee	at Below Land Surface	Ouncr (specify):		
Drawdown [(B) - (A)]:Feet Below Land Surface For flowing well, measured shut in head:			feet	
Test Pumping Rate:	_Gallons Per Minute	Well yielded	GPM with a	drawdown of
Duration of Pump Test (minimum 4 hours	s):hours	fee	et after	hours of pumping
· · · · · · · · · · · · · · · · · · ·		<u> </u>		

	p 1 000 (III			Juli			
1		t the above st Chism	tatements are true to	the best o	f my knowledge.	Cha	
Print Name of Pu	ımp İnsta	ller and Licer	nse No. (if applicable	<u>e)</u>	Signature of Pump	Installer	

FORTH PROPERTY OF SOME