

COAHOMA  
 L ~~0000~~ 99  
 04-05-79

MISSISSIPPI  
 BOARD OF WATER COMMISSIONERS  
 416 North State Street  
 Jackson, Mississippi 39201  
 WATER WELL DRILLERS LOG

4-5 1979 Five Co. Farmer Bros Coahoma  
 date well completed firm name county well located

LANDOWNER: Zutler Nance  
Charredal Miss

description of formations encountered	from	to
	top clay	0
fine sand	12	30
coarse sand	30	56
fine sand	56	74
sand & silt	74	112

(mailing address)

WELL LOCATION:  
 sec 9 T 36 (N) S R 4 E (W)  
3 miles EAST of BOBO  
 (distance) (direction) (nearest town)

WELL PURPOSE:  
 (home, irrigation, municipal, industrial)


- WELL COMPLETION DATA:
- (1) diameter (inches) 12"
  - (2) total depth (feet) 112
  - (3) static water level (feet) 22 <sup>below</sup> <sub>above</sub> top of ground.
  - (4) casing PVC (material), 72 (depth),  
 \_\_\_\_\_ if telescope see back.  
 (size)
  - (5) screen 40' (length), 72 (depth to top)  
12" (size), PVC (material)
  - (6) pump 30 (HP), 1600 (yield gpm)  
direct (type power)
  - (7) electric log no (yes or no)  
 \_\_\_\_\_ (organization running log)
  - (8) how well bottom plugged cap

DRILLERS REMARKS:

Mississippi Board of Water Comm.  
 MAY - 7 1979  
 RECEIVED

If well telescopes please sketch and show depths.

GROUND LEVEL

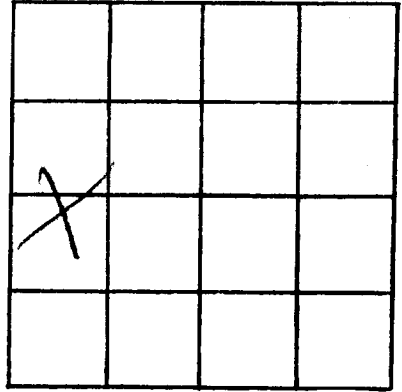

SECTION 9

Please indicate well location X.

ADDITIONAL INFORMATION

If more than one screen, show locations of each on sketch.