

County: Cochosoma
 Permit #: _____
 Driller: Will Young
 Date drilling completed: 4-20/10

State Well Report
 Part I - Driller's Log
 Mississippi Department of Environmental Quality
 Office of Land and Water Resources
 P.O. Box 10631
 Jackson, MS 39289-0631
 (601)961-5210
 (601)354-6938 (fax)

For Office Use Only:
 Aquifer: L 106
 Well #: _____
 L. S. Elevation: _____
 E-log #: _____

State Law requires that this report be prepared by the license holder responsible for the work and filed with the Department at the above address within 30 days of completion of drilling of the well or borehole.

Information on Well Owner (Landowner if borehole is not for a water well)	Well or Borehole Location
Owner Name: <u>Brent Gable</u>	Latitude: <u>34° 5' 31"</u> Longitude: <u>90° 36' 10"</u>
Mailing Address: <u>3687 Palmer Rd</u> <u>Clarksdale MS 38614</u> City State Zip Code	Method of Lat/Long (circle one): Conventional Survey, USGS quad, <u>hand-held GPS</u> , Survey-grade GPS <u>NE 1/4 SW 1/4 Sec 27</u> <u>Town 26N</u> <u>Rng 4W</u>
Telephone No. () _____	Distance Direction Nearest Town <u>7</u> Miles <u>S</u> of <u>Clarksdale</u>

Well / Borehole Data

Date drilling started: 4/20/10 Date drilling completed: 4/20/10 Hole depth: 130' Hole diameter: 24"

Location of the source of any surface water used for drilling: Local Well

Method of dosing and volume of Chlorine used in drilling and development: _____

Logs run (circle all applicable): No log run Electric Gamma Ray Density Sonic Neutron Other: _____

Name of organization running log(s): _____

Purpose of borehole (check one): Water Well Geotechnical/Geological Investigation _____ Ground Source Heat Pump _____

Seismic Survey _____ Other (describe) _____

If drilling is not related to water well construction, skip the remainder of this block

Purpose of Well (check one): Home _____ Industrial _____ Public Supply _____ Irrigation Fish Culture _____ Other: _____

If a flowing well, method of flow regulation: Valve _____ Other (describe) _____

Static Water Level: 35 feet above or below (circle one) land surface Date measured: 4-20

Method of Measurement (circle one) steel tape electric tape air line other: _____

Well depth: 130' Well grouted to a depth of 150 feet Type of grout (circle one): Neat Cement Bentonite Mix

Casing length: 90 feet Casing diameter: 16 inches Type of casing: PVC

Screen length: 40 feet Screen diameter: 16 inches Type of screen: PVC

Screen slot size: 050 inches Setting depth: From 90 feet to 130 feet

Type of completion (circle all applicable): Gravel packed Underreamed Telescoped Open hole Natural Development

Other (describe): _____


Top of lap pipe or reduction in casing: _____ feet. *If telescoped or more than one screen, describe on next page*

Form: OLWR-SWR-1A

Part 2
 replacement for CW 5929?

The sketch below only required for water wells

If well telescopes, show depths on sketch.

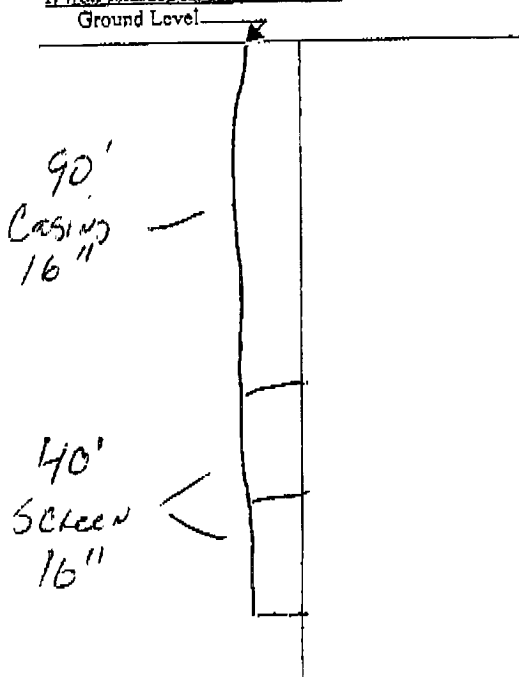

Description of formations encountered must be provided for all wells and boreholes, unless specifically exempted by regulations

Description of Formations Encountered	From (depth)	To (depth)
Gumbo	Ground Level	30
Fine Sand	30	32
Coarse Sand	32	60
Coarse Sand Gravel	60	130

If more than one screen, show location of each on sketch

Sketch the property layout and include the following: 1) the well location; 2) any permanent structures on the property that may aid in locating the well; 3) any roads, power lines, or other items that may aid in locating the property and the well; 4) a north arrow.

Landowner Name: _____

Form: OLWR-SWR-1A

I certify that the well/borehole was drilled, constructed, and completed in accordance with all applicable requirements of the Mississippi Department of Environmental Quality and the Mississippi Department of Health regulations, if applicable, and state

Will Young UNR-1995 4-20 Will Young

Print Name of Responsible Licensee and License No. Date Signature of Licensee