
GW45981 State W	all Danart		
State W	ell Report Oriller's Log	For Office Use Only:	
County: CoAHONA Part 1 - I Mississippi Department	9 1	Aquifer:	
Permit #: Office of Land at		Well#: 415	
	, MS 39225	L. S. Elevation:	
	961- 5210 I- 5228 (fax)	E-log #:	
State Law requires that this report be prepared by the lice	Lense holder responsible for th	e work and filed with the	
Department at the above address within 30 days of comp	letion of drilling of the well o	or borehole.	
Information on Well Owner (Landowner if borehole is not for a water well)	34 Well or Bor	ehole Location 39 25	
Owner Name BIG RIVEZ FARMS	Latitude: Oo	Longitude: (4) 39 25	
Mailing Address: 460 DAKPPART ALES RO	Method of Lat/Long (circle one	e): Conventional Survey,	
Walning Address. 100 Difford (Mel Present 19	USGS quad, Hand-held (
CLAPTERAL MA 381.14	NW" NW " Sec 7	_ Twn_ <u>26 N_Rng 4 W</u>	
Claure Mrs. 38614 City State Zip Code		Nearest Town	
Telephone No. (do2) 627-1465	Mileso	f	
Well / Bore	hole Data		
Date drilling started: 5-24-1 Date drilling completed: 5-24	- Hole depth: 120	Hole diameter: 261	
Location of the source of any surface water used for drilling: Method of dosing and volume of Chlorine used in drilling and development:			
Logs run (circle all applicable): No log run Electric Gamma Ray Density Sonic Neutron Other: Name of organization running log(s):			
Purpose of borehole (check one): Water Well Geotechnical/Geological Investigation Ground Source Heat Pump			
Seismic SurveyOther (describe)			
If arming is not retained to water well construction	t, skip the remulnuer of this bloc		
Purpose of Well (check one): Home Industrial Public Supply		Other:	
If a flowing well, method of flow regulation: Valve Other (describe)			
Static Water Level: 32 feet above of below (circle one) land surface Date measured: 5-24-12			
Method of Measurement (circle one) steel tape electric tape air line other:			
Well depth: 120 Well grouted to a depth of 10 feet Type of grout (circle one): Neat Cement Bentonite Mix			
Casing length: 80 feet Casing diameter:			
Screen length: 40 feet Screen diameter: 101 inches Type of screen: 700			
Screen slot size: 050 inches Setting depth: From 60 feet to 70 feet			
Type of completion (circle all applicable): Gravel packed Underreamed Telescoped Open hole Natural Development			
Other (describe):			

Top of lap pipe or reduction in casing: ______feet. If telescoped or more than one screen, describe on next page

Form: OLWR PRO TO TO

*The sketch below only required for water wells

If well telescopes, show depths on sketch.

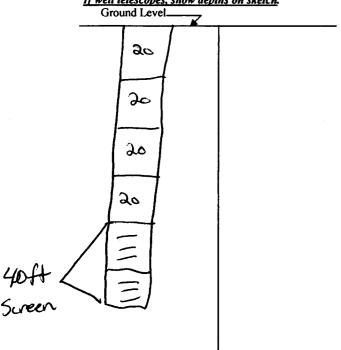

Description of formations encountered must be provided for all wells and boreholes, unless specifically exempted by regulations

Description of Formations Encountered	From (depth)	To (depth)
Clay	Ground Level	10
Clay	10	9
Clay	90	30
Clay	30	40
Fine scend	40	50
Fine sind	SO	(d)
fine sand	/00	70
Course sand	70	60
Course sand	<i>5</i> 0	90
Tourse sond	90_	100
Course sand + arauch	100	110
Course sondt gravel	110	130
3		
		İ
		1
		<u> </u>

If more than one screen, show location of each on sketch

aid in locating the well; 3) an	y roads, power lines, or other items that ma	y and in locating the property and the well;
	Hwy 61	
well		
	Daven port Rd	Bob
) acc ·	Remark
ndowner Name:		

I certify that the well/borehole was drilled, constructed, and completed in accordance with all applicable requirements of the Mississippi Department of Environmental Quality and the Mississippi Department of Health regulations, if applicable, and state

laws.

0000368

Gael Gunner
Signature of Licensee

Print Name of Responsible Licensee and License No.

JUN 1 1 2012

BY: OLWR

Date drilling completed: 5.74-12 Copy information from block on Part 1

STATE WELL REPORT Part 2

Pump Installer's Completion Report

Mississippi Department of Environmental Quality Office of Land and Water Resources P.O. Box 2309 Jackson, MS 39225 (601) 961-5210 (601) 961-5228 (fax)

	For Office Use Only:
Aquifer:	6115
Well #:	
Elevation:	

		ited by a licensed water wel is filed with the Department				
	Well Owner Inform	nation		Well	Location	
Owner Name: <u>B</u> 2	G RIVER F	ARMS	Latitude: 3408.	43"	_ Longitude:	90.39.25"
Mailing Address:	460 DAYENPOR	ET ALLEN RO	Method of Lat/Lon	g (check one):	Conve	ntional Survey,
		*	USGS qu	ad, 🗌 Hand	-held GPS,	☐ Survey-grade GPS
a	ARKSDALS	ms 28618	NIN WININ	J1/4 Sec 1	7 T	26N R 4W
C	City	MS 38614 State Zip code	Distance		Neares	
Telephone No. <u>(</u>	62)627-146	o <u>5</u>				30
	Pump Type Power Type Check one Check one					
☐ Air Lift	☐ Jet	Submersible	Diesel Engine	Gaso	line Engine	Natural Gas
Bucket	Piston	Turbine	Electric Motor	Hand	I	Tractor PTO
Centrifugal	Rotary	Flowing Well	☐ Windmill	Other	(specify):	
			Horse Power Rating			
Date Pump Installed: 5-30-/2		Setting Depth:	70	0	feet	
Rated Pump Capacity	3000	Gallons Per Minute	Number of Stages:		<i>!</i>	
Pump Test Data		Method of Measuring Water Level Check one				
Date Well Tested:			☐ Air Line	Electric 1	Measuring Lin	e Steel Tape
Static Water Level (A	i): <u>32</u>	Feet Below Land Surface	Other (specify):			
Pumping Water Leve	l (B):	Feet Below Land Surface				
		For flowing well, n	neasured shut ir	n head:	feet	
Test Pumping Rate:		Gallons Per Minute	Well yielded		(GPM with a drawdown of
Duration of Pump Te	tion of Pump Test (minimum 4 hours): hours feet after hours of pu			hours of pumping		
This is for (che	ck one):	w Well Replacer	nent of Existing Pump	Re	pair of Existing	Pump
I HEREBY CERTIF	Y that the above staten	nents are true to the best of m	ıy knowledge.		2	90.
DAVID F		-752P		of Pump Installe		
		*				ELLEIVEL)

JUL 0 2 2012 BY: OLWR²⁰⁷