State Well Report		
·	- Driller's Log	For Office Use Only:
Mississippi Denar	tment of Environmental Quality	Aquifer:
	Office of Land and Water Resources	
l	P.O. Box 2309 kson, MS 39225	
	601)961- 5210	L. S. Elevation:
Data drilling completed: Sel 7e Le	1)961-5228 (fax)	E-log #:
State Law requires that this report be prepared by the Department at the above address within 30 days of c		
Information on Well Owner		rehole Location
(Landowner if borehole is not for a water well)		
Owner Name Young Tr., WE		" Longitude: 34° 07,377
	Method of Lat/Long (circle of	ne): Conventional Surve. 42
Mailing Address: 1359 Wells Station vo	M	GPS, Survey-grade GPS
		Twn 260 Rng 04W
Mouth's 11/ 3810	S JW % NE% Sec 18	Twn dev Rng Uq(U)
City State Zip Code	Distance Direction	Nearest Town
		of Clarksdale
Telephone No. (662) 902-3276		
Well /	Borehole Data	
Date drilling started: 5-19-12 Date drilling completed: 5-19-12 Hole depth: 118 Hole diameter: 210in		
Location of the source of any surface water used for drilling:	uell west of ne	w well #36277
Method of dosing and volume of Chlorine used in drilling and	levelopment:	
Logs run (circle all applicable): No log run Electric Gamma Ray Density Sonic Neutron Other: Name of organization running log(s):		
Purpose of borehole (check one): Water Well Geotechnical/Geological Investigation Ground Source Heat Pump		
Seismic Survey Other (describe)		
If drilling is not related to water well construction, skip the remainder of this block		
Purpose of Well (check one): Home Industrial Public Supply Irrigation Fish Culture Other:		
If a flowing well, method of flow regulation: Valve Other (describe)		
Static Water Level: 36ff feet above or below (circle one) land surface Date measured: 5-20-12		
Method of Measurement (circle one) steel tape electric tape air line other:		
Well depth: Well grouted to a depth of 10 feet Type of grout (circle one): Neat Cement Bentonite Mix		
Casing length:		
Screen length: 40 feet Screen diameter: loin inches Type of screen: JVL		
Screen slot size: 050 inches Setting depth: From 078 feet to 118 feet		
Type of completion (circle all applicable): Gravel packed Underreamed Telescoped Open hole Natural Development		
Other (describe):		
Top of lap pipe or reduction in casing:feet. If telescoped or more than one screen, describe on next page		


Form: OLWR-SWR-1A (04/08)

RECEIVED

JUN 0 8 2012

The sketch below only required for water wells

If well telescopes, show depths on sketch.

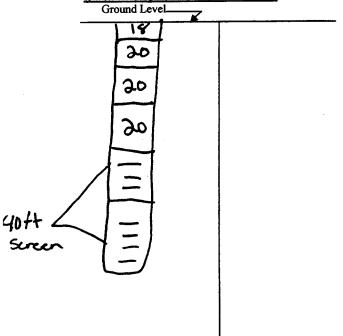

Description of formations encountered must be provided for all wells and boreholes, unless specifically exempted by regulations

From (depth)	Γο (depth)
Ground Level	10
10	20
90	30
30	40
40	50
50	(20)
(00	70
70	80
80	70
90	100
100	110
110	118
	<u> </u>
	
1	
	
-	_
	30 30 50 60

If more than one screen, show location of each on sketch

Sketch the property layout and include the following: 1) the well location; 2) any permanent structures on the property the aid in locating the well; 3) any roads, power lines, or other items that may aid in locating the property and	hat may the well;
4) a north arrow.	ĺ
Bolo New Africa	
13060 New ATTICAL	
X /500P/	
Tours of the same	
(a)	
•	
	*
Landowner Name: Young Jr, WE	
	SWR-1A (04/08)

I certify that the well/borehole was drilled, constructed, and completed in accordance with all applicable requirements of the Mississippi Department of Environmental Quality and the Mississippi Department of Health regulations, if applicable, and state RECEIVET Toget Tunger WW368 5-19-12

Print Name of Responsible Licensee and License No. Date

Signature of Licensee

JUN 6 2017

BY: OLWA

STATE WELL REPORT

Permit #: MS-GW-46052 Driller: Toel Tumper Date completed: 5-20-12

Copy information from block on Part 1

Part 2 Pump Installer's Completion Report

Mississippi Department of Environmental Quality
Office of Land and Water Resources
P.O. Box 2309

Lackson MS 39225

Jackson, MS 39225 (601)961-5210 (601)961-5228 (fax)

For Office Use Only:		
Aquifer:		
Well #:	L119	
Elevation:		

	Pump Type Circle one			Power Type Circle one	
Air Lift	Jet	Submersible	Diesel Engine	Gasoline Engine	Natural Gas
Bucket	Piston	Turbine	Electric Motor	Hand	Tractor PTO
Centrifugal	Rotary	Flowing Well	Windmill	Other (specify):	
Other (specify):			Horse Power Rating	g of Motor: <u>LeO</u>	<u>H.P.</u>
Date Pump Installed:	5-20-	12	Setting Depth:	70ft	f cc t
Rated Pump Capacity:	3200	Gallons Per Minute	Number of Stages:	Single	

Pump Test Data	Method of Measuring Water Level Circle one	
Date Well Tested: 5-20-12 Static Water Level (A): 36+ Feet Below Land Surface	Air Line Electric Measuring Line Steel Tape	
Static Water Level (A): 50 Feet Below Land Surface Pumping Water Level (B): 50 Feet Below Land Surface	Other (specify):	
Drawdown [(B) – (A)]:Feet Below Land Surface	For flowing well, measured shut in head:feet	
Test Pumping Rate: 2200 Gallons Per Minute	Well yieldedGPM with a drawdown of	
Duration of Pump Test (minimum 4 hours):hours	feet afterhours of pumping	

I HEREBY CERTIFY that the above statements are true to the best of n	
Joel Jumper RPD-0000-4842	B ROBBER Star Region F Started No.
Print Name of Pump Installer and License No. (if applicable)	Signature of Pump Installer
	Form: OLWR-SWR-1B (04/08)
	JUN (* 8° 2017)