04-4- V	Voll Doport				
County: Cohence Part 1 - Driller's Log		For Office Use Only:			
Mississippi Department of Environmental Quality Aquifer		Aquifer			
P.O. Box 2309		Well #: L 26			
		L. S. Elevation:			
Date drilling completed: 7^{-1} (601)961-5228 (fax)		E-log #:			
State Law requires that this report be prepared by the license holder responsible for the work and filed with the					
Department at the above address within 30 days of com Information on Well Owner		or borehole. rehole Location			
(Landowner if borehole is not for a water well)					
Owner Name CamPBell, MilDered, Trys	Latitude: <u><u><u></u></u><u></u><u><u></u><u></u><u></u><u></u><u></u><u></u><u></u><u></u><u></u><u></u><u></u><u></u><u></u><u></u><u></u></u></u>	" Longitude: <u>90° 35°, 95</u> "			
Mailing Address: 8318 north TAux	Method of Lat/Long (circle on	e): Conventional Survey,			
Driva		GPS, Survey-grade GPS			
	SE 1/ NE 1/ Sec_ 30	Twn 26h Rng 04W			
Hauston Tx 77040 City State Zip Code	Distance Direction	Nearest Town			
Telephone No. ()	Miles	M DUNCAN			
Well / Bore	hole Data				
Date drilling started: <u>9-1-13</u> Date drilling completed: <u>1-1-13</u> Hole depth: <u>105</u> Hole diameter: <u>25</u>					
Location of the source of any surface water used for drilling:	opment:				
Logs run (circle all applicable) No log run Electric Gamma Ray Density Sonic Neutron Other:					
Purpose of borehole (check one): Water Well	ogical Investigation Ground S	Source Heat Pump			
Seismic Survey Other (describe)	·				
If drilling is not related to water well construction	n, skip the remainder of this bloc	<u>:k</u>			
Purpose of Well (check one): Home Industrial Public Supply	Irrigation Fish Culture	Other:			
If a flowing well, method of flow regulation: Valve Ot					
Static Water Level: feet above or below (circle one) la	and surface Date measured:	9-9-13			
Method of Measurement (circle one) (steel tape electric tape	air line other:				
Well depth: \underline{IUS} Well grouted to a depth of \underline{IU} feet Type of	of grout (circle one): Neat Cemer	nt Bentonite Mix			
Casing length: 65 feet Casing diameter: 16 inches Type of casing: Pl'C					
Screen length: 40 feet Screen diameter: 16 inches Type of screen: $90c$					
Screen slot size: $D \zeta \overline{C}$ inches Setting depth: From	Screen slot size: 050 inches Setting depth: From feet to feet				
Type of completion (circle all applicable): Gravel packed Underreamed Telescoped Open hole Natural Development					
Other (describe):					
Top of lap pipe or reduction in casing: feet. If telescoped or more than one screen, describe on next page					
Form: OLWR-SWR-1A (04/08)					

×7


RECEMED

SEP 2 5 2013

BY: OUWA

6126


The sketch below only required for water wells

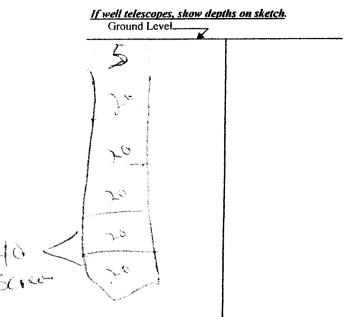

Description of formations encountered must be provided for all
weus and porenoies, unless specifically exempled by regulations

Description of Formations Encountered	From (depth)	To (depth)
	Ground Level	20
C. im Bi	20	40
Coumpo	10	60
Sara	60	40
Peus Samp'	6-1	,00
CURVE	100	5
<u> </u>		
	<u> </u>	

If more than one screen, show location of each on sketch

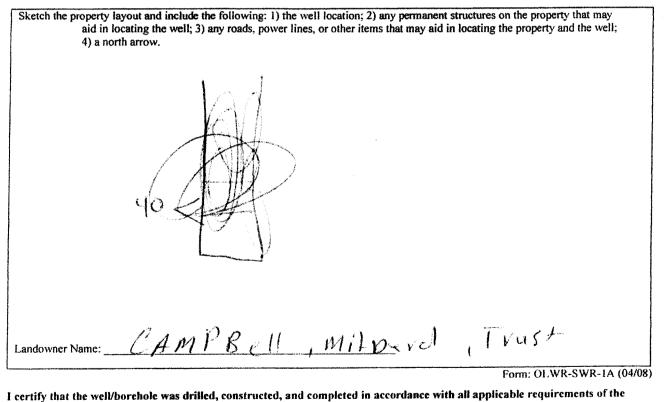

Mississippi Department of Environmental Quality and the Mississippi Department of Health regulations, if applicable, and state

laws. 9 Date

Print Name of Responsible Licensee and License No.

Signature of Licensee

SEP 2 5 2013

EIVED

101

SIAIL W	ELL REPORT				
County: Cohume	Part 2	For Office Use Only:			
Permit #:	er's Completion Report nent of Environmental Quality	well #:			
Driller: $\underline{\mathcal{TEDD}} = (\mathcal{OC})$ Office of La	nd and Water Resources				
Date completed: 1: 1: 13	.O. Box 2309 on, MS 39225-2309	Aquifer:			
Copy information from block on Part 1	501)961-5210				
(601) 360-0535 (fax)					
This part of the report must be completed by a licensed water well contractor or a licensed pump installer. A copy of Part 1 of the report must be attached and both parts filed with the Department at the above address within 30 days of well completion.					
Well Owner Information	· Well Lo	ocation			
Owner Name: ComBell MilDave Trust					
Mailing Address: 5315 Herth Tahur	Method of Lat/Long (check one)	: Conventional Survey,			
Drive	USGS quad, Hand-held GP	S, Survey-grade GPS			
Houston TK 77040 City State Zip Code	<u>SE 1/4 NE 1/4, Sec</u> _	30 T. 26M R. OYU			
	Miles of	(Nearest Town)			
Telephone No. ()	(Distance) (Direction)	(Nedrest Town)			
	e (circle one)				
Submersible Turbine Air Lift Centrifugal Flowing Well					
Date Pump Installed: <u>9-9-13</u> R	ated Pump Capacity:	Gallons Per Minute			
Is This Pump (circle one): New Repaired Replacemen					
	e (circle one)				
Electric Diesel Gasoline Natural Gas Tractor PTO Wind					
Horse Power Rating of Motor: Setting Depth	n:/ Gfeet Number of	of Stages:			
	Pump Test Data for Non Flowing Well				
Date Well Tested: <u>7-9-13</u> Duration of Pump Test (<i>minimum 4 hours</i>): <u></u> hours					
Static Water Level (A): Feet Below Land Surface Pumping Water Level (B): Feet Below Land Surface					
Drawdown [(B) - (A)]:Feet Below Land Surfa		222 Gallons Per Minute			
Drawdown [(B) - (A)]:Feet Below Land Surfa Method of measurement (circle one): Steel tape (Electric tap	ice Test Pumping Rate:	2700 Gallons Per Minute			
Drawdown [(B) - (A)]:Feet Below Land Surfa Method of measurement (circle one): Steel tape (Electric tap Pump Test Data	ce Test Pumping Rate:	2700 Gallons Per Minute			
Drawdown [(B) - (A)]:Feet Below Land Surfa Method of measurement (circle one): Steel tape / Electric tap Pump Test Data Measured shut in head:feet.	ice Test Pumping Rate: De Air line Other (<i>describe</i>): a for Flowing Well	2700 Gallons Per Minute			
Drawdown [(B) - (A)]:Feet Below Land Surfa Method of measurement (circle one): Steel tape (Electric tap Pump Test Data	ice Test Pumping Rate: De Air line Other (<i>describe</i>): a for Flowing Well	2700 Gallons Per Minute			
Drawdown [(B) - (A)]:Feet Below Land Surfa Method of measurement (<i>circle one</i>): Steel tape / Electric tap Pump Test Data Measured shut in head:feet. Well yieldedGPM with a drawdown of/	ice Test Pumping Rate: De Air line Other (<i>describe</i>): a for Flowing Well	2700 Gallons Per Minute			
Drawdown [(B) - (A)]:Feet Below Land Surfa Method of measurement (<i>circle one</i>): Steel tape / Electric tap Pump Test Data Measured shut in head:feet. Well yieldedGPM with a drawdown of/	ice Test Pumping Rate: De Air line Other (<i>describe</i>): a for Flowing Well feet afterh istallation	Gallons Per Minute			
Drawdown [(B) - (A)]:Feet Below Land Surfa Method of measurement (circle one): Steel tape / Electric tap Pump Test Data Measured shut in head:feet. Well yieldedGPM with a drawdown of Meter In	ace Test Pumping Rate: De Air line Other (<i>describe</i>): a for Flowing Well feet afterh Istallation Meter Serial Number:	Callons Per Minute ours of pumping			
Drawdown [(B) - (A)]:Feet Below Land Surfa Method of measurement (<i>circle one</i>): Steel tape / Electric tap Pump Test Data Measured shut in head:feet. Well yieldedGPM with a drawdown of/ Meter In Meter Manufacturer:	ace Test Pumping Rate: De Air line Other (<i>describe</i>): a for Flowing Well feet afterh istallation Meter Serial Number: Type of Meter:	Cours of pumping			
Drawdown [(B) - (A)]:Feet Below Land Surfa Method of measurement (<i>circle one</i>): Steel tape / Electric tap Pump Test Data Measured shut in head:feet. Well yieldedCGPM with a drawdown of/ Meter In Meter Manufacturer: Meter Model Number/Name:	ace Test Pumping Rate: De Air line Other (<i>describe</i>): a for Flowing Well feet afterh istallation Meter Serial Number: Type of Meter: 1000, etc):	Control of pumping			
Drawdown [(B) - (A)]:Feet Below Land Surfa Method of measurement (circle one): Steel tape / Electric tap Pump Test Data Measured shut in head:feet. Well yieldedGPM with a drawdown of Meter Ir Meter Manufacturer: Meter Model Number/Name: Totalizer Register Unit and Multiplier Factor (AF x .001, gal x	ace Test Pumping Rate: De Air line Other (<i>describe</i>): a for Flowing Well feet afterh feet afterh feet afterh feet after	Gallons Per Minute			
Drawdown [(B) - (A)]:Feet Below Land Surfa Method of measurement (circle one): Steel tape / Electric tap Pump Test Data Measured shut in head:feet. Well yieldedGPM with a drawdown of Meter In Meter Manufacturer: Meter Model Number/Name: Totalizer Register Unit and Multiplier Factor (AF x .001, gal x Installation Date: Meter installed by:	t tiffying that this meter was installed	Contracturer Standards			
Drawdown [(B) - (A)]:Feet Below Land Surfa Method of measurement (circle one): Steel tape / Electric tap Pump Test Data Measured shut in head:feet. Well yieldedGPM with a drawdown of/ Meter Ir Meter Manufacturer: Meter Model Number/Name: Totalizer Register Unit and Multiplier Factor (AF x .001, gal x Installation Date: Meter installed by: Is This Meter (circle one): New Repaired Replacemen Important: By submitting the above information you are cert	ice Test Pumping Rate: De Air line Other (<i>describe</i>): a for Flowing Well feet afterh istallationMeter Serial Number: Type of Meter: t 1000, etc): t t t t t t t t t t t t t	Contracturer Standards			
Drawdown [(B) - (A)]:	ice Test Pumping Rate: De Air line Other (<i>describe</i>): a for Flowing Well feet afterh istallationMeter Serial Number: Type of Meter: t 1000, etc): t t t t t t t t t t t t t	Contracturer Standards			
Drawdown [(B) - (A)]:	t t t t t t t t t t t t t t t t t t t	Contracturer Standards			

••• e

