

County: COAHOMA
 Permit #: MS-6W-49468
 Driller: TEDDY COATS
 Date drilling completed: 11-2-16

State Well Report
 Part 1 - Driller's Log
 Mississippi Department of Environmental Quality
 Office of Land and Water Resources
 P.O. Box 2309
 Jackson, MS 39225
 (601)961-5210
 (601)961-5228 (fax)

For Office Use Only:
 Aquifer: _____
 Well #: L144
 L. S. Elevation: _____
 E-log #: _____

State Law requires that this report be prepared by the license holder responsible for the work and filed with the Department at the above address within 30 days of completion of drilling of the well or borehole.

Information on Well Owner
 (Landowner if borehole is not for a water well)
 Owner Name: Wen Dell Schmitt
 Mailing Address: _____
4681 Bobo Rana Lake Rd
Clarksdale MS 38614
 City State Zip Code
 Telephone No. () _____

Well or Borehole Location
 Latitude: 34° 7' 15" Longitude: 90° 35' 7"
 Method of Lat/Long (circle one): Conventional Survey, _____

 USGS quad, Hand-held GPS, Survey-grade GPS
SE SW 1/4 Sec 14 Twn 26 Rng 04W
 Distance Direction Nearest Town
2.8 Miles S of Clarksdale

Well / Borehole Data
 Date drilling started: 11/2/16 Date drilling completed: 11/2/16 Hole depth: 120 Hole diameter: 28
 Location of the source of any surface water used for drilling: Forest + Well
 Method of dosing and volume of Chlorine used in drilling and development: _____
 Logs run (circle all applicable): No log run Electric Gamma Ray Density Sonic Neutron Other: _____
 Name of organization running log(s): _____
 Purpose of borehole (check one): Water Well Geotechnical/Geological Investigation _____ Ground Source Heat Pump _____
 Seismic Survey _____ Other (describe) _____
 If drilling is not related to water well construction, skip the remainder of this block


Purpose of Well (check one): Home _____ Industrial _____ Public Supply _____ Irrigation Fish Culture _____ Other: _____
 If a flowing well, method of flow regulation: Valve _____ Other (describe) _____
 Static Water Level: 20 feet above or below (circle one) land surface Date measured: 11/2/16
 Method of Measurement (circle one) steel tape electric tape _____ air line _____ other: _____
 Well depth: 120 Well grouted to a depth of 10 feet Type of grout (circle one): Neat Cement Bentonite Mix
 Casing length: 80 feet Casing diameter: 16 inches Type of casing: PVC
 Screen length: 40 feet Screen diameter: 16 inches Type of screen: PVC
 Screen slot size: 050 inches Setting depth: From 0 feet to 70 feet
 Type of completion (circle all applicable): Gravel packed _____ Underreamed _____ Telescoped _____ Open hole _____ Natural Development
 Other (describe): _____
 Top of lap pipe or reduction in casing: _____ feet. If telescoped or more than one screen, describe on next page

Form: OLWR-SWR-1A (04/08)
 RECEIVED
 DEC 19 2016
 BY OLWR

The sketch below only required for water wells


Description of formations encountered must be provided for all wells and boreholes, unless specifically exempted by regulations

If well telescopes, show depths on sketch.

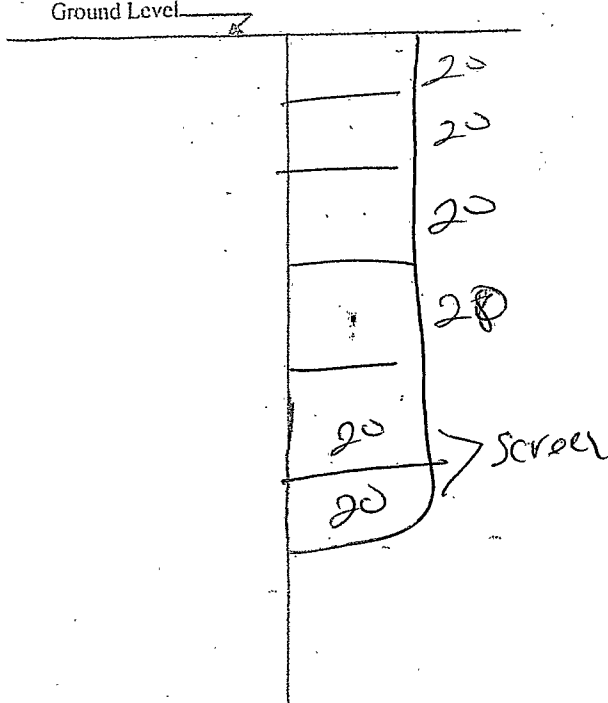

Description of Formations Encountered	From (depth)	To (depth)
D: 24	Ground Level	20
D: 24	20	40
loam con	40	60
corals & lerna	60	80
corals	80	100
brasil	100	120

If more than one screen, show location of each on sketch

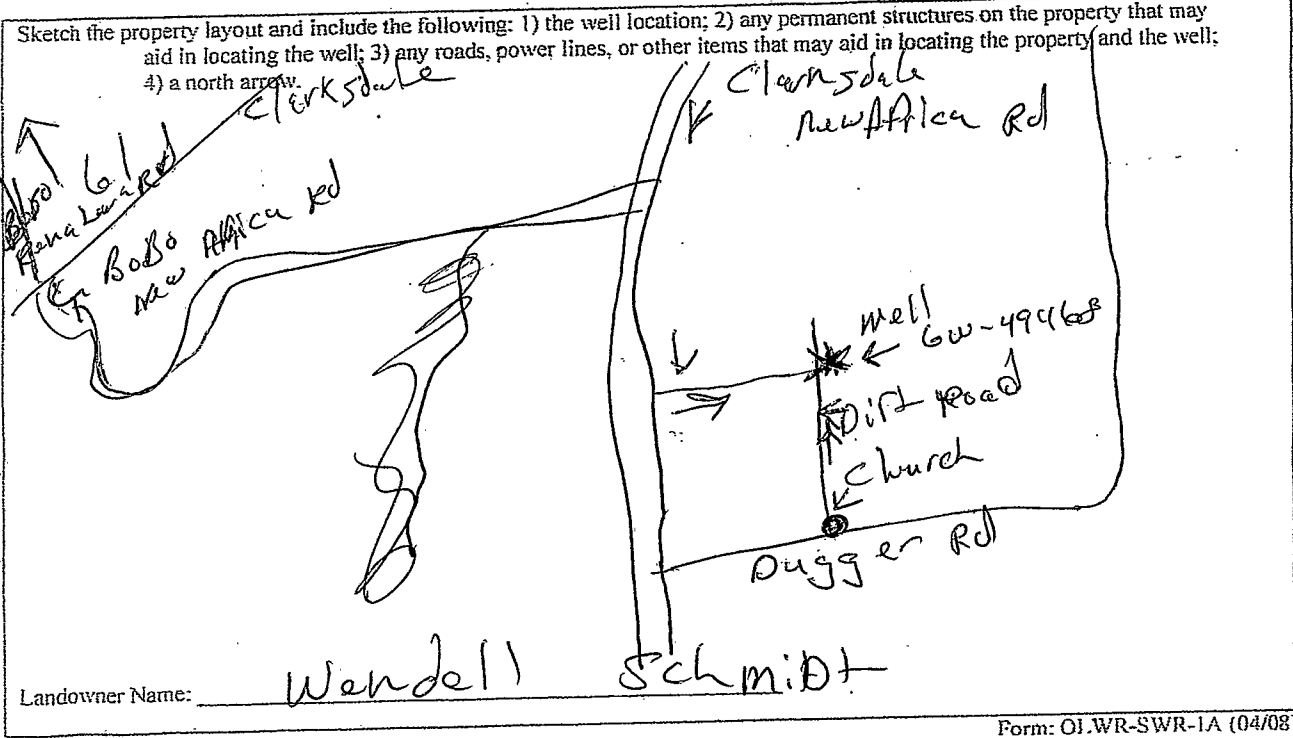

Form: OI.WR-SWR-1A (04/08)

I certify that the well/borehole was drilled, constructed, and completed in accordance with all applicable requirements of the Mississippi Department of Environmental Quality and the Mississippi Department of Health regulations, if applicable, and state laws.

Teddy Bous # 5318 # 11/2/15
Print Name of Responsible Licensee and License No. Date

Judy Coats
Signature of Licensee

RECEIVED
DEC 19 2016
BY OLWR

STATE WELL REPORT

Part 2

Pump Installer's Completion Report
 Mississippi Department of Environmental Quality
 Office of Land and Water Resources
 P.O. Box 2309
 Jackson, MS 39225
 (601)961-5210
 (601)961-5228 (fax)

County: COAHOMA
 Permit #: MS-BW-49468
 Driller: TEDDY LOOTS
 Date completed: 11/2/16
Copy information from block on Part 1

For Office Use Only:

Aquifer: _____
 Well #: L144
 Elevation: _____

This part of the report must be completed by a licensed water well contractor or a licensed pump installer. A copy of Part 1 of the report must be attached and both parts filed with the Department at the above address within 30 days of well completion.

Well Owner Information	Well Location
Owner Name: <u>Wendell Schmidt</u>	Latitude: <u>34.715</u> Longitude: <u>90.357</u>
Mailing Address: _____ <u>4681 Bobo Renee Lane Rd</u> <u>Clarksdale MS 38614</u> <small>City State Zip Code</small>	Method of Lat/Long (check one): Conventional Survey _____ USGS quad _____, Hand-held GPS <input checked="" type="checkbox"/> , Survey-grade GPS _____ NE ^{SE} <u>1/4 SW</u> 1/4 Sec <u>14 T 26 R 04 W</u>
Telephone No. () _____	Distance _____ Direction _____ Nearest Town _____ <u>3</u> Miles <u>S</u> of <u>Clarksdale</u>

Pump Type Circle one	Power Type Circle one
Air-Lift Jet Submersible	<u>Diesel Engine</u> Gasoline Engine Natural Gas
Bucket Piston <u>Turbine</u>	Electric Motor Hand Tractor PTO
Centrifugal Rotary Flowing Well	Windmill Other (specify): _____
Other (specify): _____	Horse Power Rating of Motor: _____
Date Pump Installed: <u>11/2/16</u>	Setting Depth: _____ feet
Rated Pump Capacity: <u>2500</u> Gallons Per Minute	Number of Stages: _____

Pump Test Data	Method of Measuring Water Level Circle one
Date Well Tested: <u>11/2/16</u>	Air Line <u>Electric Measuring Line</u> Steel Tape
Static Water Level (A): <u>20</u> Feet Below Land Surface	Other (specify): _____
Pumping Water Level (B): <u>40</u> Feet Below Land Surface	For flowing well, measured shut in head: _____ feet
Drawdown [(B) - (A)]: <u>20</u> Feet Below Land Surface	Well yielded _____ GPM with a drawdown of _____ feet after _____ hours of pumping
Test Pumping Rate: <u>2500</u> Gallons Per Minute	
Duration of Pump Test (minimum 4 hours): <u>4</u> hours	

I HEREBY CERTIFY that the above statements are true to the best of my knowledge.


TEDDY LOOTS #8318 Teddy Loots
 Print Name of Pump Installer and License No. (if applicable) Signature of Pump Installer

Form: OLWR-SWR-1B (04/08)
 RECEIVED
 DEC 19 2016
 BY OLWR

LI44



Clarksdale
Mississippi

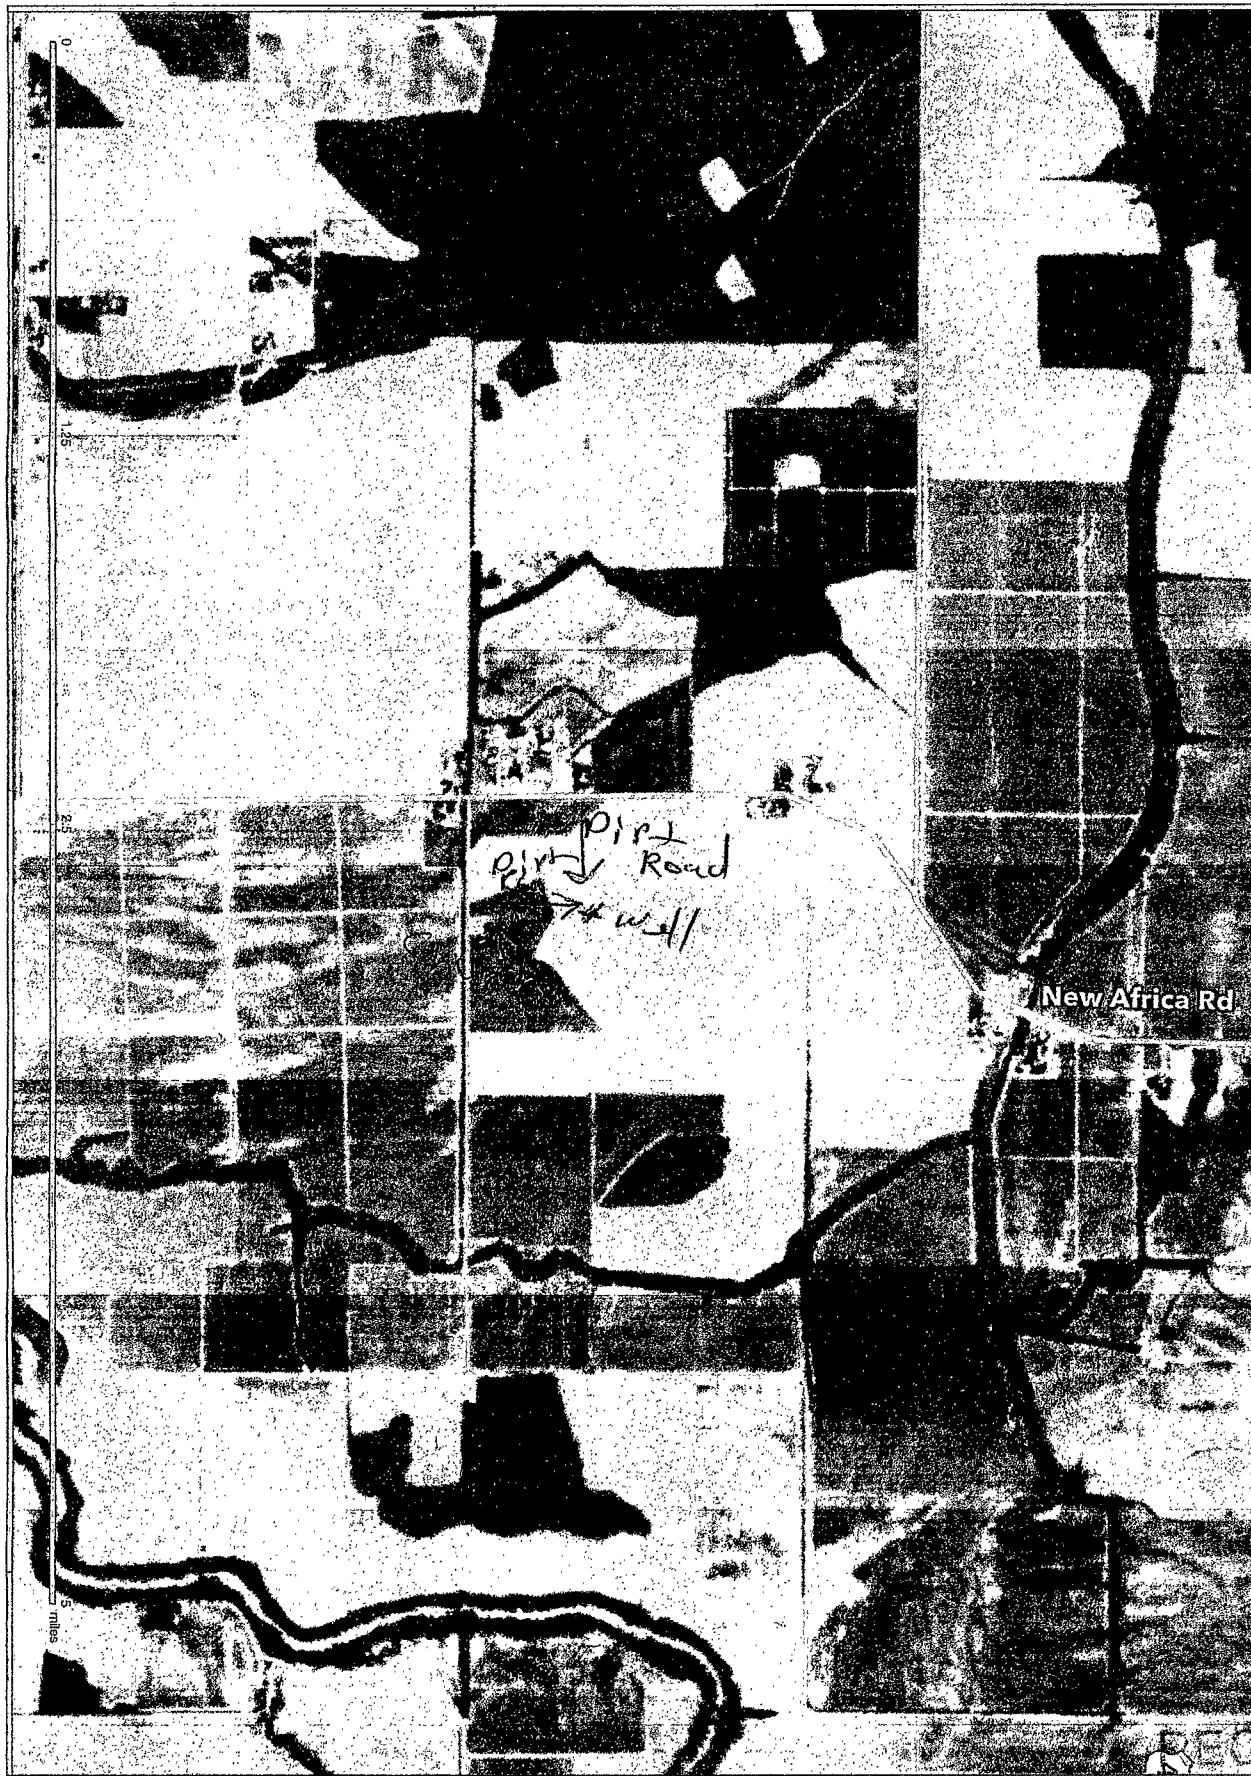

Printed from my iPhone

Page 1 of 1

RECEIVED

DEC 19 2016

BY OLWR

