

COAHOMA MISSISSIPPI BOARD OF WATER COMMISSIONERS

M0002

7-27-64

WATER WELL DRILLERS LOG

Date: 7-27, 1964, Driller: Fair County Farmers Assn. County: Coahoma  
(Name)

(1) Owner of Land:	Description & Color of Materials Sand, Clay, Red Clay, Shell, etc.	Thick- ness Feet	Depth Feet
<u>RA Carson</u> <small>(Name)</small> <u>Clarksdale Min</u> <small>(Address)</small>	<u>0-14" Top Soil</u> <u>14" to 21" Clay</u> <u>21" to 53" Blue mud</u> <u>53" to 66" "</u>	<u>14"</u> <u>6"</u> <u>32"</u> <u>13"</u>	<u>14 1/2'</u> <u>21'</u> <u>53 1/2'</u> <u>66 1/2'</u>
(2) Location: <u>1/4</u> , <u>1/4</u> , Sec. <u>13</u> <u>T28R5</u>			
<u>6</u> miles <u>SE</u> of <u>Clarksdale</u> <small>(distance) (direction) (Nearest Town)</small>	<u>66 1/2' to 105 1/2'</u>		
(3) Topography: <u>Flat</u> <small>(Hilly) (Flat) (Level)</small>	<u>Coarse sand,</u>		
(4) Purpose of Well: <u>Irrigation</u> <small>(Domestic Irrigation Municipal, Industrial, Other)</small>	<u>Red Rock + large gravel</u>	<u>39'</u>	<u>105'</u>


Information upon completion of well:

- (1) Diameter 6 inches.
- (2) Total Depth 105 feet.
- (3) Water Level 18 feet below top of ground.
- (4) Cased to 48, Size 6"
- (5) Screen: Size 6", Length 57"
- (6) Were any formations sealed against pollution?  
 yes,  no.

If YES depth of formation \_\_\_\_\_

Why \_\_\_\_\_

Drillers Remarks: \_\_\_\_\_

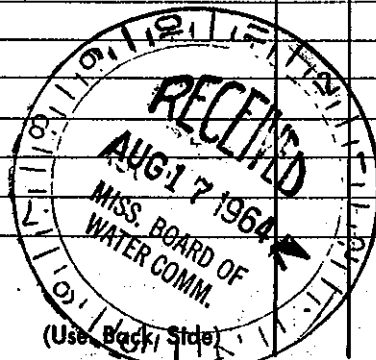

Well No. \_\_\_\_\_

is copy to Board of Water Commissioners 429 Miss. St. Jackson, Miss