

Coahoma
M5
6-66


MISSISSIPPI BOARD OF WATER COMMISSIONERS ELOG # 9

WATER WELL DRILLERS LOG

CODED

Date: JUNE 30, 1966, Driller: DELTA DRILLING Co. County COAHOMA
(Name)

(1) Owner of Land: <u>PERRY SMITHERS, JR.</u> (Name)	Description & Color of Materials Sand, Clay, Red Clay, Shell, etc.	Thick- ness Feet	Depth Feet
<u>CLARKSDALE, MISS</u> (Address)	GUMBO	28	28
(2) Location: <u>NW 1/4, SE 1/4, Sec. 6 TRUNSKY</u>	SAND	54	82
_____ miles _____ of _____ (distance) (direction) (Nearest Town)	grave)	104	186
(3) Topography: _____ (Hilly) (Flat) (Level)	gumbo	124	310
(4) Purpose of Well: <u>MUNICIPAL</u> (Domestic Irrigation Municipal, Industrial, Other)	Sand	41	351
Information upon completion of well:	gumbo	42	393
(1) Diameter <u>4</u> inches.	Sand	20	413
(2) Total Depth <u>1252</u> feet.	gumbo	263	676
(3) Water Level <u>FLUWS</u> feet below top of ground.	Sand w/ROCKS	41	717
(4) Cased to <u>1232</u> , Size <u>4" 600'</u> <u>2 1/2" 652'</u>	Shale w/ROCKS	62	779
(5) Screen: Size <u>2"</u> , Length <u>20'</u>	Sand	19	798
(6) Were any formations sealed against pollution? _____ yes, _____ no.	Shale w/ROCKS	72	870
If YES depth of formation _____	Sand - BROWN	30	900
Why _____	WHITE Sand	22	922
Drillers Remarks: <u>20' LAP OF 2 1/2"</u>	Shale	145	1067
<u>PIPE IN 4" PIPE -</u>	fine sand	63	1130
	Shale	20	1150
	GRAY sand	44	1194
	WHITE sand	53	1252

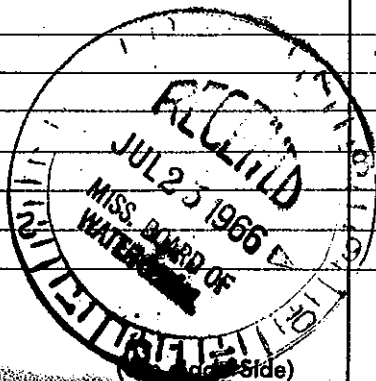

Well No.

Mail this copy to Board of Water Commissioners 429 Miss. St. Jackson, Miss