

COAHOMA

OM10

4-27-62

MISSISSIPPI BOARD OF WATER COMMISSIONERS

WATER WELL DRILLERS LOG

Coahoma
Washington

Date: 4/27, 1962, Driller: Bailey Drilling Co. (Name)

County: Washington

(1) Owner of Land: Garrett & Sons
(Name)
Clarksdale, Miss.
(Address)

(2) Location: 1/4, 1/4, Sec. 6 T26R3
3 miles SW, of Clarksdale
(distance) (direction) (Nearest Town)

(3) Topography: Flat
(Hilly) (Flat) (Level)

(4) Purpose of Well: Domestic & Ind
(Domestic Irrigation, Municipal, Industrial, Other)

Description & Color of Materials
Sand, Clay, Red Clay, Shell, etc.

Thick-
ness
Feet

Depth
Feet

Description & Color of Materials Sand, Clay, Red Clay, Shell, etc.	Thick- ness Feet	Depth Feet
Clay	41	41
Sand		88
Gravel + Sand		141
Mud		184
Sand + Mud		205
Sand		240
Hard mud		243
Sand		255
Mud		369
Sand		428
Coal		430
Mud		473
Sand + Mud		574
Sand		626
Mud + rock		907
Sand		943
Sand + Mud		1017
Mud		1065
Sand		1100
Sand + Mud		1111
Sand		1130
Mud		1146
Sand		1227

Information upon completion of well:

(1) Diameter 4x2 1/2 inches.

(2) Total Depth 1227 feet.

(3) Water Level 2 feet below top of ground.

(4) Cased to all way, Size 4x2 1/2


(5) Screen: Size 2 1/2, Length 30 ft.

(6) Were any formations sealed against pollution?
yes, X no.

If YES depth of formation

Why

Drillers Remarks:

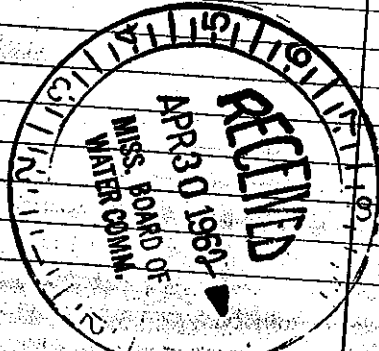

(Use Back Side)

Well No.

Mail this copy to Board of Water Commissioners 429 Miss. St. Jackson, Miss.