

COAHOMA

M 12

10-2-62

Date: OCT 2, 1962, Driller: DELTA DRILLING Co. County COAHOMA

WATER WELL DRILLERS LOG

CODED

(Name)

(1) Owner of Land: T. G. FLOWERS

(Name)

MATTSON, MISS

(Address)

(2) Location: NW 1/4, SW 1/4, Sec. 3 T2N3W

_____ miles _____ of _____
(distance) (direction) (Nearest Town)

(3) Topography: FLAT

(Hilly) (Flat) (Level)

(4) Purpose of Well: DOMESTIC

(Domestic Irrigation
Municipal, Industrial, Other)

Description & Color of Materials
Sand, Clay, Red Clay, Shell, etc.

Thick-
ness
Feet

Depth
Feet

SAND	69	69
GRAVEL	91	160
SAND	114	274
GUMBO	14	288
SAND	12	300
SHALE	26	326
GUMBO	62	388
SHALE W/ROCK	37	425
GUMBO	144	569
SHALE	37	606
GUMBO	32	638
SAND W/ROCK	14	652
GUMBO	28	680
SHALE	25	705
GUMBO W/ROCK	51	756
SAND	8	764
GUMBO	14	778
SHALE W/ROCK	41	819
SAND	52	871
SHALE	54	925
GUMBO	43	968
SHALE	32	1000
SAND	38	1038
GUMBO	13	1051
SAND	25	1076
GUMBO	26	1102
SHALE	13	1115
SAND	14	1129
SHALE	36	1165
SAND	22	1187

Information upon completion of well:

(1) Diameter 3 inches.

(2) Total Depth 1187 feet.

(3) Water Level _____ feet below top of ground.

(4) Cased to 1187, Size 3x2"

(5) Screen: Size 2", Length 20'

(6) Were any formations sealed against pollution?


_____ yes, _____ no.

If YES depth of formation _____

Why _____

Drillers Remarks: _____

CODED

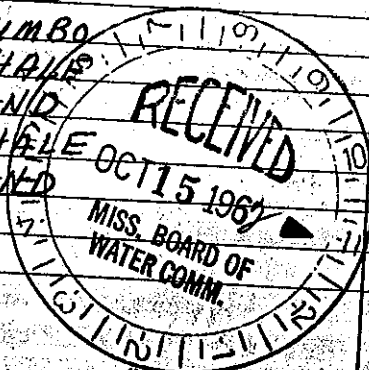

(Use Back Side)

Well No.

Mail this copy to Board of Water Commissioners 429 Miss. St. Jackson, Miss.