

COAHOMA  
MO27

MISSISSIPPI DEPARTMENT OF NATURAL RESOURCES  
Bureau of Land and Water Resources  
Southport Mall  
P.O. Box 10631  
Jackson, Mississippi 39209

CODED

WATER WELL DRILLERS LOG

3 / 1986  
date well completed

Powell Irrigation  
firm name

COAHOMA  
county well located

LANDOWNER:

HARRY Flowers

description of formations encountered

Top Soil &  
CLAY

from 0 to 13

MATTSON MS 38758  
(mailing address)

BROWN CLAY  
FINE SAND  
COARSE SAND  
& GRAVEL

13 5/8  
33 5/8  
52 1/2


WELL LOCATION:

sec. 20 T26N R. 3 W  
2 miles W of MATTSON  
(distance) (direction) (nearest town)

WELL PURPOSE: IRRIGATION  
(home, irrigation, municipal, industrial)

WELL COMPLETION DATA:

- (1) diameter (inches) 16"
- (2) total depth (feet) 113
- (3) static water level (feet) 22 below top of ground
- (4) casing 16" Steel 73' (material) (depth)
- 16" (size) if telescope see back.
- (5) screen 40" (length) 73' (depth to top)
- 16" Steel (size) (material)
- (6) pump 60 HP 2000 (type power) (yield gpm)
- Diesel
- (7) electric log No (yes or no)

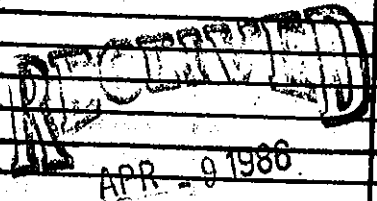

APR 9 1986

Department of Natural Resources  
Bureau of Land & Water Resources

(organization running log)

(8) how well bottom plugged Steel  
PLATED

DRILLERS REMARKS: 86028CMG-1