

Cashon

MISSISSIPPI BOARD OF WATER COMMISSIONERS

Card 7969
JWC

N 14
10/28/65

WATER WELL DRILLERS

CODED Alabama

Date: 10/28, 1965, Driller: Bailey Drilling Co. (Name) County: Washington

(1) Owner of Land:	Description & Color of Materials Sand, Clay, Red Clay, Shell, etc.	Thick- ness Feet	Depth Feet
Glenn McCoy (Name) Clarksdale, Miss. (Address)	Clay		80
3 4 2 5 N 4 W (Location: 1/4, 1/4, Sec. T R)	Sand		110
1.5 miles S of Clarksdale (distance) (direction) (Nearest Town)	Gravel		130
Flat (Topography: (Hilly) (Flat) (Level))	Mud		307
Domestic (Purpose of Well: (Domestic Irrigation) (Municipal, Industrial, Other))	Sand		430
	Mud		500
	Sand		605
	Mud		720
	Rocks		726
	Mud		820
	Rock		821
	Mud		840
	Rocks		842
	Mud		880
	Rock		881
	Mud		971
	Sand		1000
	Mud		1169
	Sand		1185
	Mud		1205
	Sand		1275
	Mud		1302
	Sand		1368
	Sand + Coal		1371


Information upon completion of well:

- (1) Diameter 4 X 3 inches.
- (2) Total Depth 1364 feet.
- (3) Water Level 3 feet above top of ground.
- (4) Cased to all way Size 4 X 3.
- (5) Screen: Size 3, Length 30 ft.
- (6) Were any formations sealed against pollution?
yes, no.

If YES depth of formation _____

Why _____

Drillers Remarks: _____

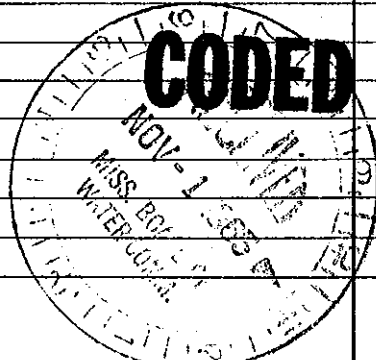

(Use Back Side)

Well No.

Mail this copy to Board of Water Commissioners 429 Miss. St. Jackson, Miss.