

COAHOMA MISSISSIPPI BOARD OF WATER COMMISSIONERS

N 26

6-14-63

WATER WELL DRILLERS LOG

CODED


6/20/63 N
C1603

Date: June 14, 1963, Driller: Layne-Central Company County Coahoma

(Name)

	Description & Color of Materials Sand, Clay, Red Clay, Shell, etc.	Thick- ness Feet	Depth Feet
(1) Owner of Land: <u>J. R. Weeks</u> (Name)	<u>Clay</u>	<u>58</u>	<u>58</u>
<u>Roundaway, Mississippi</u> (Address)	<u>Coarse sand</u>	<u>17</u>	<u>75</u>
(2) Location: <u>1/4, 1/4, Sec. 28</u> <u>T21N</u> <u>R 4W</u>	<u>Coarse sand, pea gravel</u>	<u>25</u>	<u>100</u>
<u>_____</u> miles <u>_____</u> of <u>Roundaway</u> (distance) (direction) (Nearest Town)	<u>Coarse sand, pea gravel,</u> <u>gravel</u>	<u>12</u>	<u>112</u>
(3) Topography: <u>flat</u> (Hilly) (Flat) (Level)			
(4) Purpose of Well: <u>irrigation</u> (Domestic Irrigation Municipal, Industrial, Other)			
Information upon completion of well:			
(1) Diameter <u>16</u> inches.			
(2) Total Depth <u>112</u> feet.			
(3) Water Level <u>22' - 6"</u> feet below top of ground.			
(4) Cased to <u>62'</u> , Size <u>16"</u>			
(5) Screen: Size <u>16"</u> , Length <u>50'</u>			
(6) Were any formations sealed against pollution?			
<u>_____</u> yes, <u>no</u> no.			
If YES depth of formation _____			
Why _____			
Drillers Remarks: _____			

CODED

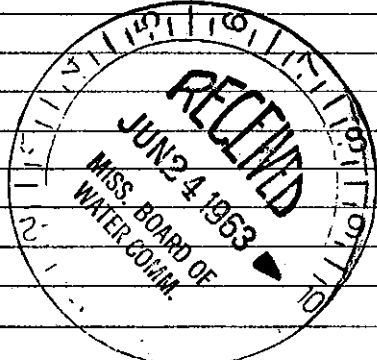

(Use Back Side)

Well No.

Mail this copy to Board of Water Commissioners 429 Miss. St. Jackson, Mis