

COAHOMA MISSISSIPPI BOARD OF WATER COMMISSIONERS

N27  
8-6-64

WATER WELL DRILLERS LOG


10/5/64  
CODED

Date: Aug. 6, 1964, Driller: Layne-Central Company, Coahoma

(Name)

(1) Owner of Land: <u>J. R. Weeks Plantation</u> (Name)	Description & Color of Materials Sand, Clay, Red Clay, Shell, etc.	Thick- ness Feet	Depth Feet
<u>Roundaway, Mississippi</u> (Address)	Clay	18	18
(2) Location: <u>1/4</u> , <u>1/4</u> , Sec. <u>28</u> <sup>T25N</sup> <sub>T</sub> <u>R4W</u>	Fine sand	19	37
<u>1/4</u> miles <u>Roundaway</u> (distance) (direction) (Nearest Town)	Coarse sand	23	60
(3) Topography: <u>flat</u> (Hilly) (Flat) (Level)	Coarse sand & pea gravel	58	118
(4) Purpose of Well: <u>domestic</u> (Domestic Irrigation Municipal, Industrial, Other)	Clay	27	151
Information upon completion of well:	Sand	69	220
(1) Diameter <u>8x4</u> inches.	Clay	11	231
(2) Total Depth <u>1367'-9"</u> feet.	Sandy clay strks. sand	17	248
(3) Water Level <u>6'-3"</u> feet below top of ground.	Sand	42	290
(4) Cased to <u>135'-8"</u> , Size <u>8"</u>	Sand strks. lignite	37	327
(5) Screen: Size <u>4"</u> , Length <u>30'-4"</u>	Sand strks. sandy clay	56	383
(6) Were any formations sealed against pollution?	Sand	111	494
<u>yes</u> yes, <u>no</u> no.	White sandy clay & sand strks.	23	517
If YES depth of formation <u>Cemented, Mechanical seal, packer above screen and Why B.P.V. at bottom.</u>	Sand	49	562
Drillers Remarks:	White clay strks. sand	24	586
	Sandy shale sand strks.	32	618
	Sandy shale	62	680
	Clay	40	720
	Shale	25	745
	Rock	6	751
	Shale	5	756
	Rock	1	757
	Shale strks. thin rocks	18	775
	White clay	6	781
	Shale	15	796
	Hard shale & white clay	46	832
	Rock	2	834
	Shale	32	866
	Rock	22	888
	Shale	75	943
	Hard clay	55	998

CODED

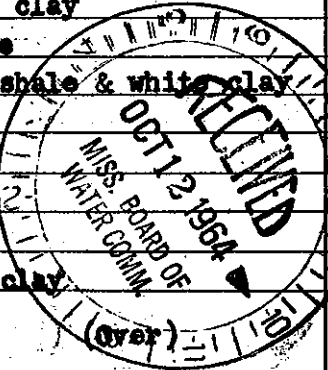

(Use Back Side)

Well No.

Mail this copy to Board of Water Commissioners 429 Miss. St. Jackson, Miss.