

Coahoma
N 30
10-67

MISSISSIPPI
BOARD OF WATER COMMISSIONERS
416 North State Street
Jackson, Mississippi 39201

CODED

C 2544

WATER WELL DRILLERS LOG

October 2, 19 67 Layne-Central Company Coahoma
date well completed firm name county well located

LANDOWNER: David Manker

Clarksdale, Mississippi
(mailing address)

WELL LOCATION:

sec. 15 T 25 S R 4 E
2 miles east of Roundaway
(distance) (direction) (nearest town)


WELL PURPOSE: home
(home, irrigation, municipal, industrial)

WELL COMPLETION DATA:

- (1) diameter (inches) 4x3
- (2) total depth (feet) 618
- (3) static water level (feet) 24' below top of ground.
- (4) casing steel 5 1/4" 6"
(material) (depth)
1 1/2" 3" If telescope see back.
(size) of 4x3 swage
- (5) screen 31' 576'
(length) (depth to top)
3" Stainless Steel
(size) (material)
- (6) pump 2 38
(HP) (yield gpm)
electric
(type power)
- (7) electric log no
(yes or no)
(organization running log)
- (8) how well bottom plugged 75 lbs.
of lead shot.

description of formations encountered	from	to
Top soil	0	5
Clay, red	5	20
Coarse sand	20	35
Fine green sand	35	64
Coarse white sand	64	106
Pea gravel & sand	106	128
Clay	128	149
Sandy clay	149	200
Sand	200	281
Clay	281	288
Sand	288	300
Clay	300	335
Sand with clay strks.	335	456
Sand	456	486
Clay	486	525
Sand	525	530
Clay	530	540
Sand	540	575
Clay	575	582
Sand	582	588
Sandy clay	588	618

CODED

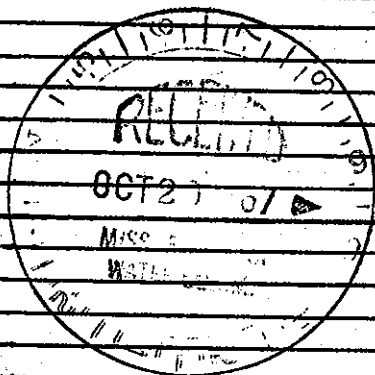

DRILLERS REMARKS: