

Cookoma
N45
3-16-81

MISSISSIPPI DEPARTMENT OF NATURAL RESOURCES
 Bureau of Land and Water Resources
 Southport Mall
 P.O. Box 10631
 Jackson, Mississippi 39209
WATER WELL DRILLERS LOG

GW 5915
 SE/NE, Sec. 6,
 T25N, R4W
 Elev. 155

37

3-16-81
 date well completed

Dyer
 firm name

Cookoma
 county well located

LANDOWNER: Moscot
Clarksdale, MS
 (mailing address)


description of formations encountered	from to	
	ft	ft
CLAY	0	13
FINNE SAND	13	93
COARSE SAND & GRAVEL	93	111

WELL LOCATION:
 sec. 6 T. 25 N. R. 4 W.
4 miles NW of Rondaway
 (distance) (direction) (nearest town)

WELL PURPOSE:
 (home, irrigation, municipal, industrial)

- WELL COMPLETION DATA:
- (1) diameter (inches) 16
 - (2) total depth (feet) 111
 - (3) static water level (feet) 221 below top of ground.
 - (4) casing 16 111'
 (material) (depth)
16" If telescope see back.
 (size)
 - (5) screen 40' 61'
 (length) (depth to top)
16" Steel
 (size) (material)
 - (6) pump 60 3000
 (HP) (yield gpm)
ELC
 (type power)
 - (7) electric log (yes or no)
 - (organization running log)
 - (8) how well bottom plugged photo

COILED

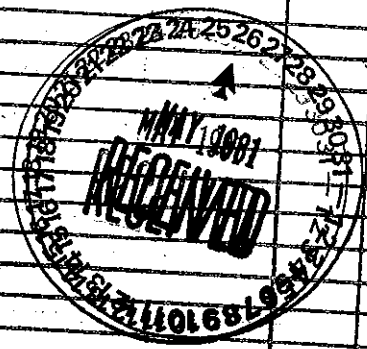

DRILLERS REMARKS: