
County: Coahoma Oan Permit #: GW 39878 Mississippi Department Irrigation Equipment Office of Land and P.O. Boo Date drilling completed: 12-21-04 Jackson, MS Magazion (601)96 (601)354- Magazion Equipment, bnC State Law requires that this report be prepared by the displayed by the displaye	of Environmental Quality Aquifer: d Water Resources Well #: // - ///7 xx 10631 Use 14:: // - ///7 39289-0631 L. S. Elevation: 51-5210 E-log #:	
30 days of completion of drilling of the well. Well Owner Information	Well Location	
Owner Name_ Bob Waits	Latitude: <u>34 • 00 • 59</u> " Longitude: <u>90 • 38 • 36</u> "	
2120 Commentant Deed	-	
	Method of Lat/Long (circle one): Conventional Survey,	
South Suite 2	USGS quad, Hand-held GPS, Survey-grade GPS	
Germantown, TN 38138 City State Zip Code	<u>NE 1/4 NE 1/4 Sec_30 Twn 25N Rng 4W</u>	
	Distance Direction Nearest Town 	
Well Da	ita	
Purpose of Well (circle one) Home Industrial Public Supply (Date well drilling started:12-21-04 Date we If flowing, method of flow regulation: Valve Other (des Static Water Level:feet above or below (circle one) has Method of Measurement (circle one) steel tape electric tape Hole depth:111 ' Well depth:111 ' Type of grout (circle one): Cement Bentonite Mix Casing length:feet Casing diameter:6 Screen length:feet Screen diameter:16 Screen slot size:feet Screen diameter:16 Type of completion (circle all applicable): Type of completion (circle all applicable): Other (describe):	ell drilling completed:	
	······································	
Top of lap pipe or reduction in casing:feet. If tele Logs run (circle all applicable) No log run) Electric Gamma Ray		
Name of organization running log(s): I certify that the well was drilled, constructed, and completed in ac Department of Environmental Quality and/or the Mississippi Depa Irrigation Equipment Inc. Patrick M. Chism 0695		
Print Name of Water Well Contractor and License No.	Signature of Water Well Contractor	
Customer contracted with Circle S Ir Mailed Part 1 copy & Part 2 1-6-05 t	rigation (627-7246), $RECEWE$	

If well telescopes please sketch below and show depths.

Ground Level

Description of Formations Encountered	From	То
Clay	0	48
Fine Sand	49	53
Med. Sand/gravel	54	65
Fine Sand/gravel	66	70
Med. Sand/gravel	71	107
Clay	108	111
1		
· · · · · · · · · · · · · · · · · · ·		

If more than one screen, show location of each on sketch

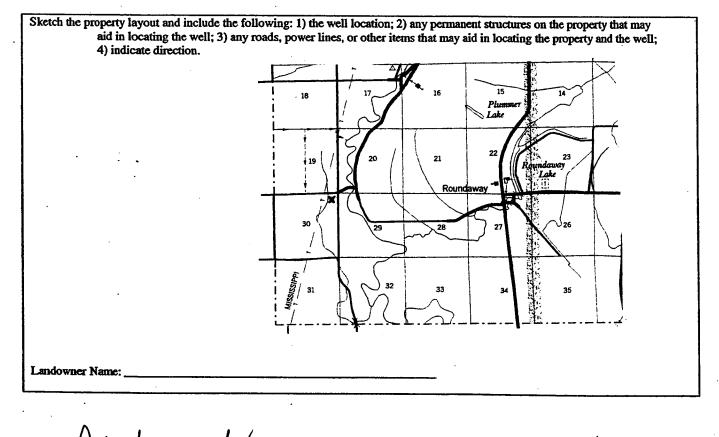

Signature of Water Well Contractor