State We	II Report	Far Office Use Only:
Day	41	Aquifer:
ounty: <u>Coahoma</u> Mississippi Department of and and	of Environmental Quality 1 Water Resources	Well #: 1/-132
Permit #: P.O. Bo	X 10031	L S. Elevation:
Dallar Jackson, ma	39289-0631 61-5210	
Date drilling completed: (601)354	-6938 (fax)	E-log #:
State Law requires that this report be prepared by the of the second state law requires that this report be prepared by the second state law requires that this report be prepared by the second state law requires that this report be prepared by the second state law requires that this report be prepared by the second state law requires that this report be prepared by the second state law requires that this report be prepared by the second state law requires that this report be prepared by the second state law requires that this report be prepared by the second state law requires that this report be prepared by the second state law requires that this report be prepared by the second state law requires that this report be prepared by the second state law requires that this report be prepared by the second state law requires that this report be prepared by the second state law requires that the second state law requires that this report be prepared by the second state law requires that this report be prepared by the second state law requires that this report be prepared by the second state law requires that this report be prepared by the second state law requires that the second state law requires the second state law requires that the second state law requires	Iriller in detail and filed v	with the Department within
State Law requires that this report be prepared by the c 30 days of completion of drilling of the well.	We	Il Location
Well Owner Information	34 03 43.	1 Location 90 33 58.0W
Dulaney Farms	Latitude:	
Owner Name Mailing Address:6933 Sunflower School Rd	Method of Lat/Long (circle	one): Conventional Survey,
Mailing Address:	USGS quad, Hand-he	ld GPS, Survey-grade GPS
	SE % SW % Sec 1	Twn_25N Rng_4W
Clarksdale MS 38614	Direction	Nearest Town
City Suite Lip code	<u>3</u> Miles Nort	h of Roundaway
662-627-7060 Telephone No. ()		
	Data	li li timore e contra de la contra
Home Industrial Public Supply	Irrigation Fish Culture	OtherUCT-2. 1.2006
Purpose of Well (circle one) Home Industrial Public Supply 9-27-06 Date	well drilling completed:	9-27-06
Date well drilling started: <u>9-27-00</u> Date	(Jenniha)	YMD JOINT WATER MANAGEMENT DISTRICT
Date well drilling started Other		MANAGEMENT 10-2-06
If flowing, method of flow regulation: Valve Oner Static Water Level: feet above or below (circle one) land surface Date measure	
Method of Measurement (circle one) seel take electric tag	pe air ine cuien_	
Hole depth: <u>136</u> Well depth: <u>136</u>	Well grouted to a depth	of <u>10</u>
Hole depuir	ix	
Type of grout (circle one). Comment	inches Type of casi	ng: <u>PVC Sch.40</u> .
16		en: PVC Sch. 40
Casing length:feet Screen diameter:16		
Server slot size: 050 inches Setting depth: From	m <u>77</u> feet to	Orac hole Natural Development
Trues of completion (circle all applicable): Oravel packed U		Open hole Natural Development
feet.	If telescoped or more than e	one screen, describe on back of page
Top of lap pipe or reduction in casing: rect Logs run (circle all applicable): No log run Electric Gamma	Ray Density Sonic Neu	utron Other:
Logs run (circle all applicable): No log run Elecule Gamma	-	the standard
Name of organization running log(s): I certify that the well was drilled, constructed, and complete	d in accordance with all ap	plicable requirements of the Mussissippi
I certify that the well was drilled, constructed, and complete Department of Environmental Quality and/or the Mississipp	pi Department of Health reg	ulations and state laws.
Transportion Equipment Inc.	V.F	-1 m chis 1
Patrick M. Chism 0095		nature of Water Well Contractor
Print Name of Water Well Contractor and License No.		

41346

	State Well Report	For Office Use Only:
County: Coahoma	Part 1	
M. (1)41346	fississippi Department of Environmental	Quality Aquifer:
Permit #: <u>6W 4/346</u> Irrigation Equipment	Office of Land and Water Resource	s Well #: <u>M-1-5</u>
Daller	P.O. Box 10631	•
Date drilling completed: $9-27-07$	Jackson, MS 39289-0631 (601)961-5210	L. S. Elevation:
Date onling completed:	(601)354-6938 (fax)	E-log #:
	t be prepared by the driller in detail an	
30 days of completion of drilling of	the well.	Well Location
Well Owner Informatio	34 03	Well Location 3 43.7 90 33 58.0W
Owner Name	Latitude:	' Longitude:' "
Mailing Address: 6933 Sunflowe	r School Rd Method of Lat/Long	g (circle one): Conventional Survey,
	USGS quad,	Hand-held GPS, Survey-grade GPS
		Sec_1Twn25N Rng_4W
<u>Clarksdale M</u>	IS 38614	
City State		Direction Nearest Town
662-627-7060 Telephone No. ()		North of Roundaway
	Well Data	·
Purpose of Well (circle one) Home Indust		Culture Other:
Date well drilling started: $9-27-0$	6 Date well drilling complete	d:9-27-06
If flowing, method of flow regulation: Valve	Conter (describe)	
Static Water Level: 42' feet abov	-	
Method of Measurement (circle one) see	I tape electric tape air line ot	her:
Hole depth: <u>136</u> Well depth	Well grouted to a	depth of <u>10</u> feet
Type of grout (circle one): Cement	Bentonite Mix	
Casing length: 76 feet Casing	diameter 16 inches Type of	fcasing: PVC Sch.40
<u> </u>		screen: PVC Sch.40
		х. Х
Screen slot size: <u>.050</u> inches	Setting depth: Fromfeet	
Type of completion (circle all applicable):	Gravel packed Underreamed Telescope	d Open hole Natural Development
	Other (describe):	
Top of lap pipe or reduction in casing:	feet. If telescoped or more the	an one screen, describe on back of page
		Neutron Other:
Logs run (circle all applicable): No log run	Electric Gamma Ray Density Sonic	
Name of organization running log(s):		
Logs run (circle all applicable): No log run Name of organization running log(s): I certify that the well was drilled, construc Department of Environmental Quality and	ted, and completed in accordance with all	applicable requirements of the Mississippi
Name of organization running log(s): I certify that the well was drilled, construc Department of Environmental Quality and	ted, and completed in accordance with all d/or the Mississippi Department of Health	applicable requirements of the Mississippi
Name of organization running log(s): I certify that the well was drilled, construc Department of Environmental Quality and Irrigation Equipment	ted, and completed in accordance with all d/or the Mississippi Department of Health nt Inc.	applicable requirements of the Mississippi
Name of organization running log(s): I certify that the well was drilled, construc Department of Environmental Quality and Irrigation Equipment	ted, and completed in accordance with all dor the Mississippi Department of Health nt Inc. 0695	applicable requirements of the Mississippi

•

••

•


DCT 17 2006 BY: OLWR If well telescopes please sketch below and show depths.

Ground Level

Description of Formations Encountered	From	To
	0	34
Clay Fine Sand	35	45
Fine Sand/gravel Med. Sand/gravel	46	67
Med Sand/gravel	68	136
neu, banu/graver		
		
		<u> </u>
		<u> </u>
		+-+
	_+	┝╾╼┤

N- . .

If more than one screen, show location of each on sketch

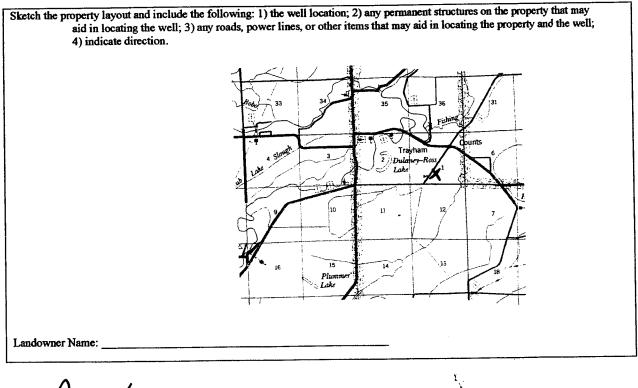

Signature of Water Well Contractor

		STATE W	ELL REPORT		
County: Coaho		Part 2 Pump Installer's Completion Report		For Office Use Only:	
Promit to U 9 Irrigation	n Equipment		and Water Resources	Aquifer: Well #: <u>133</u> Elevation:	
Driller:			Box 10631 MS 39289-0631		
Date completed:			1)961-5210 54-6938 (fax)		
Copy information for			l contractor or a licensed pump i	nstaller. A copy of Part 1 of the	
report must be att	tached and both parts j Well Owner Inform	filed with the Department	at the above address within 30 d	ays of well completion.	
Di	ulaney Farms				
6933 St	unflower Sch	nool Road		_Longitude:	
Mailing Address:		· · · · · · · · · · · · · · · · · · ·		ne): Conventional Survey,	
-			USGS quad, Hand-held	GPS, Survey-grade GPS	
_	Clarksdale			<u>T25N</u> R 4W	
	Čity State 62-627-7060	z Zip Code	Distance Direction	Nearest Town	
)		3 Mikes North	f_Roundaway	
				<u></u>	
	Pump Type Circle one			wer Type Sircle one	
41 1 10					
Air Lift	Jet	Submersible			
Bucket		Turbine	Electric Motor Hand		
Centrifugal	Rotary	Flowing Well	•	(specify):	
			Horse Power Rating of Moto		
Date Pump Installe	d: 10-2	2-06	Setting Depth:8	tting Depth: 80 feet	
Rated Pump Capac	 3500±	Gallons Per Minute	Number of Stages:1		
	Pump Test Dat	ta	Method of Measuring Water Level Circle one		
Date Well Tested:				asuring Line Steel Tape	
Static Water Level	(A):Fe	eet Below Land Surface	Air Line Electric Measuring Line Site Tape Other (specify):		
Pumping Water Le	wel (B):Fe	et Below Land Surface	Other (specify):		
Drawdown [(B)-	(A)]: Fe	et Below Land Surface	For flowing well, measured :	shut in head:feet	
		Gallons Per Minute	_	GPM with a drawdown of	
		s): hours		hours of pumping	
Paradon of Limb	-	<u> </u>			
	- '			<u> </u>	
		tements are true to the bes	tof my knowledge.		
Patrick M	1. Chism 06 pinstaller and Licens	95 • No. (if applicable)	Signature of Pump	(MM)	
A LINE AND UN FUIL	IP INSIGNA AND LIGHTS	A THON (IT SUBMINING)	ergnanie or r diff)	Form: OLWR-SW	
<u></u>				RECE	
<u></u> <u></u> 1939.					
				001 17 BY: OL	