

County: Cochran
 Permit #: QW42058
 Driller: Pete's Well Drilling
 Date drilling completed: 7-27-07

Well Driller Report and Well Log

Mississippi Department of Environmental Quality
 Office of Land and Water Resources
 P.O. Box 10631
 Jackson, MS 39289-0631
 (601)961-5210
 (601)354-6938 (fax)

For Office Use Only:
 Aquifer: _____
 Well #: N139
 L. S. Elevation: _____
 E-log #: _____

State Law requires that this report be prepared by the driller in detail and filed with the Department within 30 days of completion of drilling of the well.

Well Owner Information	Well Location
Owner Name: <u>Natures Catch</u> Mailing Address: <u>1090 WALLIS RD</u> <u>Clarksdale MS 38614</u> City State Zip Code Telephone No. <u>(662) 627-1482</u>	Latitude: <u>33° 59' 34.0" N</u> Longitude: <u>90° 34' 39.5" W</u> Method of Lat/Long (circle one): Conventional Survey, USGS quad, <u>Hand-held GPS</u> Survey-grade GPS <u>NE 1/4 SE 1/4 Sec 35 Twn 25N Rng 04W</u> Distance Direction Nearest Town <u>Approx 10 Miles SE of Clarksdale</u>

Well Data

Purpose of Well (circle one) Home Industrial Public Supply Irrigation Fish Culture Other: _____
 Date well drilling started: 7-27-07 Date well drilling completed: 7-27-07
 If flowing, method of flow regulation. Valve _____ Other (describe) _____
 Static Water Level: 34' feet above or below (circle one) land surface Date measured: _____
 Method of Measurement (circle one) steel tape electric tape _____ other _____
 Hole depth: 100' Well depth: 100' Well grouted to a depth of 10 feet
 Type of grout (circle one): Cement Bentonite Mix SEP - 4 2007
 Casing length: 60 feet Casing diameter: 16 inches IMD JOINT WATER PVL
 Screen length: 40 feet Screen diameter: 16 inches MANAGEMENT DISTRICT PVL
 Screen slot size: .032 inches Setting depth: From 60 feet to 100 feet
 Type of completion (circle all applicable): Gravel packed Underreamed Telescoped Open hole Natural Development
 Other (describe): _____
 Top of lap pipe or reduction in casing: _____ feet. If telescoped or more than one screen, describe on back of page
 Logs run (circle all applicable): No log run Electric Gamma Ray Density Sonic Neutron Other: _____

Name of organization running log(s): _____
 I certify that the well was drilled, constructed, and completed in accordance with all applicable requirements of the Mississippi Department of Environmental Quality and/or the Mississippi Department of Health regulations and state laws.
Pete's Well Drilling 0431
 Print Name of Water Well Contractor and License No. _____
 Signature of Water Well Contractor _____

If well telescopes please sketch below and show depths.

42058

County: Cook
 Permit #: GW42058
 Driller: Pete's Well Drilling
 Date drilling completed: 7-27-07

Well Driller Report and Well Log

Mississippi Department of Environmental Quality
 Office of Land and Water Resources
 P.O. Box 10631
 Jackson, MS 39289-0631
 (601)961-5210
 (601)354-6938 (fax)

For Office Use Only:
 Aquifer: _____
 Well #: N-139
 L. S. Elevation: _____
 E-log #: _____

State Law requires that this report be prepared by the driller in detail and filed with the Department within 30 days of completion of drilling of the well.

Well Owner Information	Well Location
Owner Name: <u>Natures Catch</u>	Latitude: <u>33° 59' 34.0" N</u> Longitude: <u>90° 34' 39.5" W</u>
Mailing Address: <u>1090 WALLIS RD</u>	Method of Lat/Long (circle one): <u>Hand-held GPS</u> Conventional Survey
<u>Clarksdale MS 38614</u>	USGS quad, <u>Hand-held GPS</u> Survey-grade GPS
City State Zip Code	<u>SE 1/4 Sec 35 Twn 25N Rng 04W</u>
Telephone No. <u>(662) 627-1482</u>	Distance Direction Nearest Town <u>Approx 10 Miles SE of Clarksdale</u>

Well Data

Purpose of Well (circle one) Home Industrial Public Supply Irrigation Fish Culture Other: _____

Date well drilling started: 7-27-07 Date well drilling completed: 7-27-07

If flowing, method of flow regulation: Valve _____ Other (describe) _____

Static Water Level: 34' feet above or below (circle one) land surface Date measured: _____

Method of Measurement (circle one) steel tape electric tape air line other: _____

Hole depth: 100' Well depth: 100' Well grouted to a depth of 10 feet

Type of grout (circle one): Cement Bentonite Mix

Casing length: 60 feet Casing diameter: 16 inches Type of casing: PVC

Screen length: 40 feet Screen diameter: 16 inches Type of screen: PVC

Screen slot size: .032 inches Setting depth: From 60 feet to 100 feet

Type of completion (circle all applicable): Gravel packed Underreamed Telescoped Open hole Natural Development

Other (describe): _____

Top of lap pipe or reduction in casing: _____ feet. If telescoped or more than one screen, describe on back of page

Logs run (circle all applicable): No log run Electric Gamma Ray Density Sonic Neutron Other: _____

Name of organization running log(s): _____

I certify that the well was drilled, constructed, and completed in accordance with all applicable requirements of the Mississippi Department of Environmental Quality and/or the Mississippi Department of Health regulations and state laws.

Pete's Well Drilling 0431
 Print Name of Water Well Contractor and License No.

Pete Sapp
 Signature of Water Well Contractor

If well telescopes please sketch below and show depths.

RECEIVED

AUG 21 2007
 BY: OLWR


Ground Level 6042058

Description of Formations Encountered

From To

Description of Formations Encountered	From	To
clay	0	58
COURSE SAND & GRAVEL	58	100

If more than one screen, show location of each on sketch

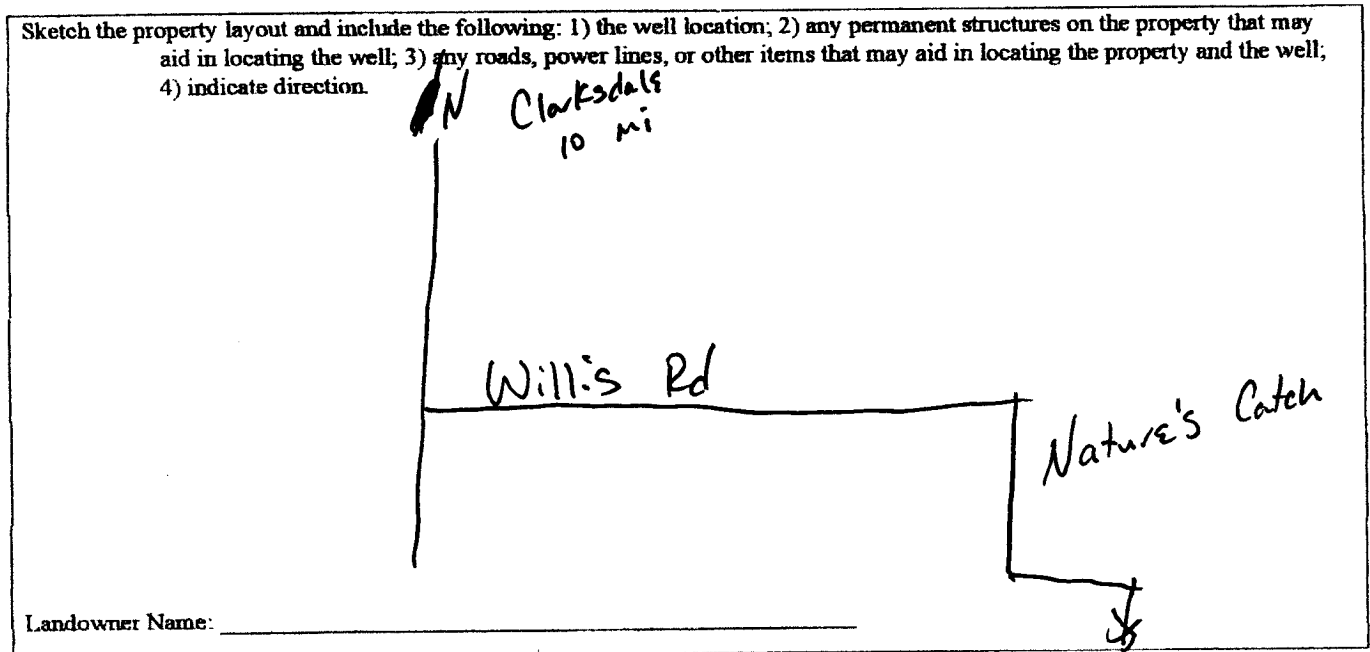

Landowner Name: _____

[Signature]

 Signature of Water Well Contractor

RECEIVED
 AUG 21 2007
 BY: OLWR

STATE WELL REPORT

Part 2

Pump Installer's Completion Report
 Mississippi Department of Environmental Quality
 Office of Land and Water Resources
 P.O. Box 10631
 Jackson, MS 39289-0631
 (601)961-5210
 (601)354-6938 (fax)

County: Coahoma
 Permit #: 6W42058
 Driller: Pete's Well Drilling
 Date completed: 7-27-07
Copy information from block on Part 1

For Office Use Only:

Aquifer: _____
 Well #: N-139
 Elevation: _____

This part of the report must be completed by a licensed water well contractor or a licensed pump installer. A copy of Part 1 of the report must be attached and both parts filed with the Department at the above address within 30 days of well completion.

Well Owner Information	Well Location
Owner Name: <u>Nature's Catch</u>	Latitude: <u>33-59-340^N</u> Longitude: <u>90-34-395^W</u>
Mailing Address: <u>1090 Willis Rd</u>	Method of Lat/Long (check one): <input checked="" type="checkbox"/> Conventional Survey <input type="checkbox"/> <u>20</u>
<u>Clarksdale MS 38614</u>	USGS quad <u>Hand-held GPS</u> , Survey-grade GPS _____
City State Zip Code	____ 1/4 ____ 1/4 Sec <u>35</u> T <u>25</u> R <u>4</u> W
Telephone No. <u>(662) 627-1482</u>	Distance Direction Nearest Town
	Approx <u>10</u> Miles <u>SE</u> of <u>Clarksdale</u>

Pump Type Circle one	Power Type Circle one
Air Lift Jet Submersible	Diesel Engine Gasoline Engine Natural Gas
Bucket Piston Turbine	<input checked="" type="checkbox"/> Electric Motor Hand Tractor PTO
Centrifugal Rotary Flowing Well	Windmill Other (specify): _____
Other (specify): _____	Horse Power Rating of Motor: <u>50</u>
Date Pump Installed: <u>7-28-07</u>	Setting Depth: <u>80</u> feet
Rated Pump Capacity: <u>2200</u> Gallons Per Minute	Number of Stages: <u>Two</u>

Pump Test Data	Method of Measuring Water Level Circle one
Date Well Tested: _____	Air Line Electric Measuring Line <input checked="" type="checkbox"/> Steel Tape
Static Water Level (A): <u>31'</u> Feet Below Land Surface	Other (specify): _____
Pumping Water Level (B): _____ Feet Below Land Surface	For flowing well, measured shut in head: _____ feet
Drawdown [(B) - (A)]: _____ Feet Below Land Surface	Well yielded _____ GPM with a drawdown of _____ feet after _____ hours of pumping
Test Pumping Rate: _____ Gallons Per Minute	
Duration of Pump Test (minimum 4 hours): _____ hours	

I HEREBY CERTIFY that the above statements are true to the best of my knowledge.

DAVID P. HOLT 0-752P
 Print Name of Pump Installer and License No. (if applicable) Signature of Pump Installer

Form: OLWR-SWR-1B

RECEIVED
 AUG 27 2007
 BY OLWR