County:	Coahoma		
Permit #:	GW-47916	√	
Driller:	Driller: Irrigation Equipment		
Date drill	ing completed:	04/18/2014	

STATE WELL REPORT

Part 1

Driller's Log
Mississippi Department of Environmental Quality
Office of Land and Water Resources P.O. Box 2309

Jackson, MS 39225-2309

(601) 961-5210

(601) 360-0535 (fax)

For	Office Use Only:
Well #:	N172
Aquifer:	
E-Log #:	

State Law requires that this report be prepared by the li Department at the above address within 30 days of com	
Well Owner Information (Landowner if borehole is not for a water well)	Well or Borehole Location
Owner Name: Creation Plantation	Latitude: 34 00' 56.97 N Longitude: 90 35' 33.26 W
Mailing Address: P.O. Box 926	Method of Lat/Long (check one): Conventional Survey,
	☐ USGS quad, ☑ Hand-ḥeld GPS, ☐ Survey-grade GPS
Aberdeen Ms 39730	NE 14 NE 14, Sec 27 T 25 N R 4 W
City State Zip code	112 74 112 74, 000 <u>01.</u> 1 <u>00.11 N 111.</u>
Telephone No	Miles East of Roundaway (Distance) (Direction) (Nearest Town)
Well / Bo	rehole Data
Date drilling started: 04/18/2014 Date drilling completed:	04/18/2014 Hole depth: 119' Hole diameter: 24"
Location of the source of any surface water used for drilling:	Surface Water
Method of dosing and volume of Chlorine used in drilling and dev	elopment: 50 PPM
Logs run (check all applicable): ☑ No log run ☐ Electric ☐ Gam	nma Ray 🔲 Density 🔲 Sonic 🗎 Neutron 🗍 Other:
Name of organization running log(s):	
Purpose of borehole (check one): ☑ Water Well ☐ Geotect	hnical/Geological Investigation
☐ Seismic Survey	Other (describe)
	nstruction, skip the remainder of this block
Purpose of Well (check all applicable): ☐ Home ☐ Industrial ☐ F	Public Supply ⊠ Irrigation □ Fish Culture
Other (describe):	
If a flowing well, method of flow regulation: Valve	Other (describe)
Static Water Level: 52 feet [□ above or ☑ belowed feet [□ above or ☑ belowed feet feet feet feet feet feet feet fe	w] land surface Date measured: 04/22/2014
Method of Measurement (check one) \boxtimes Steel tape \square Electric tape	pe Air line Other: (describe)
Well depth: 119' Well grouted to a depth of: 10' fee	t Type of grout <i>(check one)</i> : ☐ Neat Cement ☒ Bentonite ☐ Mix
Casing length: 79' feet Casing diameter: 16"	inches Type of casing: PVC
Screen length: 40' feet Screen diameter: 16"	inches Type of screen: PVC
Screen slot size:050 inches Setting depth:	From 80' feet to 119' feet
Type of completion (check all applicable): ☑ Gravel packed ☐ U	rom 80' feet to 119' feet nderreamed □ Open hole □ Natural Development RECEIVED
Other (describe):	' ILUEIVED
Top of lap pipe or reduction in casing: Feet	APR 2 9 2014 ne screen, describe on next page For Symposium (1988)
If telescoped or more than on	e screen, describe on next page For D WF-SNR (1778)
	- OCNA

		For Office U	se Only:
ounty: Coahoma	Well #:	N17:	9
ermit #: GW-47916			
	L		
e sketch below only required for water wells	Description of formations encountered		
vell telescopes, show depths on sketch.	and boreholes, unless specifically exem	pted by regulation	<u>5</u>
	Description of Formations Encounter	ed From (dep	th) To (depth)
round level	Clay	Ground le	U.
	Medium Sand	58	75
	Fine Sand	76	80
	Course Sand & Gravel	81	97
	Medium Sand & Gravel	98	101
	Course Sand & Gravel	102	119
nore than one screen, show location of each on sketch		-	
etch the property layout and include the following:	And the state of t		
the well location any permanent structures on the property that n	nay aid in locating the well		
3) any roads, power lines, or other items that may	aid in locating the property and the well		
4) a north arrow			
	,		
ndowner Name: Creation Plantation			
		Form: OLV	/R-SWR-1A (04/08)
EREBY CERTIFY that the well/borehole was drilled, uirements of the Mississippi Department of Environn	constructed, and completed in accordance	with all applicable	e
EREBY CERTIFY that the well/borehole was drilled, uirements of the Mississippi Department of Environn pplicable, and state laws.	nental Quality and the Mississippi Departm	with all applicable	e
creation Plantation EREBY CERTIFY that the well/borehole was drilled, purements of the Mississippi Department of Environm pplicable, and state laws. Itrick Chism 0695 int Name of Responsible Licensee and License No.	nental Quality and the Mississippi Department 04/23/2014	with all applicable	e lations,

APR 2 9 2014

County:	Coahoma	
	GW-47916	<u> </u>
Driller:	Irrigation Eq	uipment
Date drill	ing completed:	04/18/2014

STATE WELL REPORT Part 2

Pump Installer's Completion Report

Mississippi Department of Environmental Quality Office of Land and Water Resources P.O. Box 2309 Jackson, MS 39225-2309 (601) 961-5210

(601) 360-0535 (fax)

For Office Use Only:	
Well#:	N172
Aquifer:	

Copy information from block on Part 1

This part of the report must be completed by a licensed water well contractor or a licensed pump installer. A copy of Part 1 of the report must be attached and both parts filed with the Department at the above address within 30 days of well completion. Well Owner Information **Well Location** Latitude: 34 00' 56.97 N Longitude: 90 35' 33.26 W Owner Name: Creation Plantation Mailing Address: P.O. Box 926 □ USGS quad, ☑ Hand-held GPS, □ Survey-grade GPS 39730 NE 1/4 NE 1/4, Sec 27 T 25 N R 4 W Ms Aberdeen State Zip code City Roundaway Telephone No. East (Distance) (Direction) (Nearest Town) Pump Type (check one) ☐ Submersible ☑ Turbine ☐ Air Lift ☐ Centrifugal ☐ Flowing Well ☐ Jet ☐ Piston ☐ Rotary ☐ Other (describe): Date Pump Installed 04/22/2014 ____ Rated Pump Capacity: 1500+/-Gallons Per Minute Is This Pump (check one): ☑ New ☐ Repaired ☐ Replacement Power Type (check one) ☑ Electric ☐ Diesel ☐ Gasoline ☐ Natural Gas ☐ Tractor PTO ☐ Windmill ☐ Other (describe): Horse Power Rating of Motor: 40 Setting Depth: 80 feet Number of Stages: 2 **Pump Test Data for Non Flowing Well** Date Well Tested: Duration of Pump Test (minimum 4 hours): Hours Static Water Level (A): _____ Feet Below Land Surface Pumping Water Level (B): ____ Feet Below Land Surface Drawdown [(B) - (A)]: _____ Feet Below Land Surface Test Pumping Rate: ____ Method of measurement (check one): ☐ Steel tape ☐ Electric tape ☐ Air line ☐ Other (describe): **Pump Test Data for Flowing Well** Measured shut in head: GPM with a drawdown of feet after hours of pumping Meter Installation Meter Manufacturer: None Installed Meter Serial Number: Meter Model Number/Name: Type of Meter: Totalizer Register Unit and Multiplier Factor (AF x .001, gal x 1000, etc): Installation Date: Meter installed by:

Important: By submitting the above information you are certifying that this meter was installed to manufacturer standards. For agricultural wells, a list of approved meters is on the MDEQ website. I HEREBY CERTIFY that the above statements are true to the best of my knowledge.

Patrick Chism 04/23/2014 Print Name of Pump Installer and License No. (if applicable)

Is This Meter (check one): ☐ New ☐ Repaired ☐ Replacement


Form monited by Forms On & Dist. 044 040 0400 Forms On & Dist. com

Date

Signature of Pump Installer Form: OLWR-SWR-18 (4/13) 2014



N172

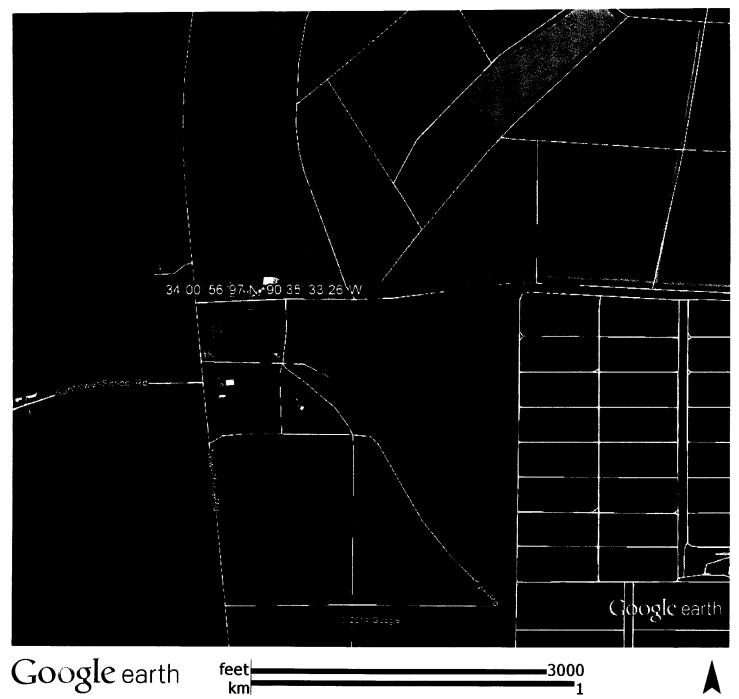

RECEIVED

APR 2 8 204

BY: OLWH