


OKLAHOMA MISSISSIPPI BOARD OF WATER COMMISSIONERS

012
1-4-61

WATER WELL DRILLERS LOG **CODED** 10-300

Date: 1/4, 1961, Driller: Fin County, Fin County, Oklahoma
(Name)

(1) Owner of Land: <u>T.G. Flowers Jr.</u> (Name)	Description & Color of Materials Sand, Clay, Red Clay, Shell, etc.	Thick- ness Feet	Depth Feet
<u>Dublin, Miss</u> (Address)	<u>clay</u>	<u>40</u>	<u>40</u>
(2) Location: <u>1/4, 1/4, Sec. 10 25th Row</u> <u>2</u> miles <u>SW</u> of <u>Dublin</u> (distance) (direction) (Nearest Town)	<u>clay & 7' sand</u> <u>chess sand & gravel</u> <u>gravel</u>	<u>10</u> <u>24</u> <u>20</u>	<u>50</u> <u>74.5</u> <u>94.5</u>
(3) Topography: <u>level</u> (Hilly) (Flat) (Level)			
(4) Purpose of Well: <u>irrigation</u> (Domestic Irrigation Municipal, Industrial, Other)			
Information upon completion of well:			
(1) Diameter <u>12</u> inches.			
(2) Total Depth <u>94.5</u> feet.			
(3) Water Level <u>25</u> feet below top of ground.			
(4) Cased to <u>58.5</u> , Size <u>12"</u>			
(5) Screen: Size <u>12"</u> , Length <u>36'</u>			
(6) Were any formations sealed against pollution? <u>yes</u> , <u>no</u> .			
If YES depth of formation _____			
Why _____			
Drillers Remarks:			
<u>Well Capacity 3,000 g.p.m.</u>			

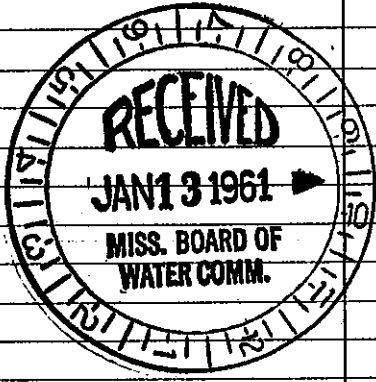

CODED

Well No.

(Use Back Side)

Mail this copy to Board of Water Commissioners 429 Miss. St. Jackson, Miss.