

2017

COAHOMA
014
3-68

MISSISSIPPI
BOARD OF WATER COMMISSIONERS
416 North State Street
Jackson, Mississippi 39201

CODED

WATER WELL DRILLERS LOG

March 15 1968 Luther Watliff Coahoma
date well completed firm name county well located


LANDOWNER: <u>C.B. Sallee</u>	description of formations encountered	from	to
<u>Tutwiler, Miss</u> (mailing address)			
WELL LOCATION: sec. <u>20</u> T. <u>25</u> N. R. <u>3</u> E <u>9 3/4</u> miles <u>E</u> of <u>Proctor</u> (distance) (direction) (nearest town)	<u>0</u> <u>Clay</u>	<u>0</u>	<u>23</u>
	<u>Sandy</u>	<u>23</u>	<u>83</u>
	<u>Sandy & gravel</u>	<u>87</u>	<u>187</u>
	<u>Sand</u>	<u>187</u>	<u>267</u>
	<u>Clay</u>	<u>267</u>	<u>307</u>
	<u>Sandy & clay</u>	<u>307</u>	<u>347</u>
	<u>Clay</u>	<u>347</u>	<u>467</u>
	<u>Sandy</u>	<u>467</u>	<u>627</u>
	<u>Clay</u>	<u>627</u>	<u>707</u>
	<u>Sandy clay & rock</u>	<u>707</u>	<u>787</u>
<u>Sand</u>	<u>787</u>	<u>1107</u>	

WELL PURPOSE: Home Farm
(home, irrigation, municipal, industrial)

WELL COMPLETION DATA:

- (1) diameter (inches) 4" X 2"
- (2) total depth (feet) 1103
- (3) static water level (feet) Top below above top of ground.
- (4) casing Galv, 1083
(material) (depth)
4" X 2" If telescope see back.
(size) 1083
- (5) screen 20, 1083
(length) (depth to top)
1/2", SS Screen
(size) (material)
- (6) pump 1 (HP) 20 (yield gpm)
Electric
(type power)
- (7) electric log no
(yes or no)
(organization running log)
- (8) how well bottom plugged 2"
Back wash valve

CODED

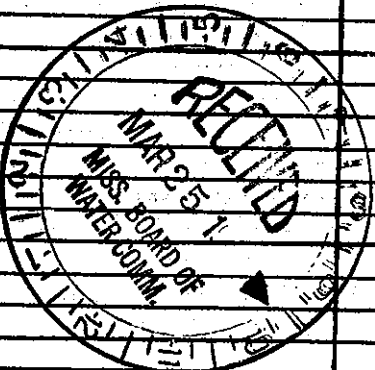

DRILLERS REMARKS: B.W.V.