

COAHOMA Co.

MISSISSIPPI BOARD OF WATER COMMISSIONERS

9-68 **020**


CODED

WATER WELL DRILLERS LOG

COAHOMA

Date: Sept, 1966, Driller: Luther Ratliff County: Jackson
(When well drilled) (Name) (Where well is located)

(1) Owner of Land: <u>Kyle & Co.</u> <small>(Name)</small>	Description & Color of Materials Sand, Clay, Red Clay, Shell, etc.	Thick- ness Feet	Depth Feet
<u>Tutwiler, Miss</u> <small>(Address)</small>	<u>0-23 clay + sand</u>		
(2) Location: <u>2W 1/4, SW 1/4, Sec. 34 T5N R3W</u>	<u>23-43 sand</u>		
<u>2</u> miles <u>NW</u> of <u>TUTWILER</u> <small>(distance) (direction) (Nearest Town)</small>	<u>43-63 sand</u>		
(3) Topography: <u>X</u> <small>(Hilly) (Flat) (Level)</small>	<u>63-83 sand</u>		
(4) Purpose of Well: <u>Farm</u> <small>(Domestic Irrigation, Municipal, Industrial, Other)</small>	<u>83-103 sand + gravel</u>		
Information upon completion of well:	<u>103-123 gravel</u>		
(1) Diameter: <u>1 1/2</u> inches.	<u>123-143 gravel + clay</u>		
(2) Total Depth: _____ feet.	<u>143-163 clay</u>		
(3) Water Level: _____ feet below top of ground.	<u>163-183 clay + sand</u>		
(4) Cased to: _____, Size: _____	<u>183-203 sand</u>		
(5) Screen: Size: _____, Length: _____	<u>203-223 sand</u>		
(6) Were any formations sealed against pollution? _____ yes, _____ no.	<u>223-243 sand</u>		
If YES depth of formation: _____	<u>243-263 sand</u>		
Why: _____	<u>263-283 sand</u>		
Drillers Remarks: _____	<u>283-303 sand + shale</u>		
Yield in gpm: <u>30</u>	<u>303-323 sand streaks</u>		
Size pump: <u>2 HP</u>	<u>323-343 sand</u>		
Type power: <u>Elec</u>	<u>343-363 sand</u>		
	<u>363-383 sand</u>		
	<u>383-403 sand + clay</u>		
	<u>403-423 clay</u>		
	<u>423-443 clay</u>		
	<u>443-463 clay + sand streaks</u>		
	<u>463-483 clay + sand streaks</u>		
	<u>483-503 sand</u>		
	<u>503-523 sand</u>		
	<u>523-543 sand + shale</u>		
	<u>543-563 sand + shale</u>		
	<u>563-583 clay</u>		
	<u>583-603 sand + shale</u>		
	<u>603-623 sand + shale</u>		
	<u>623-643 sand + clay</u>		

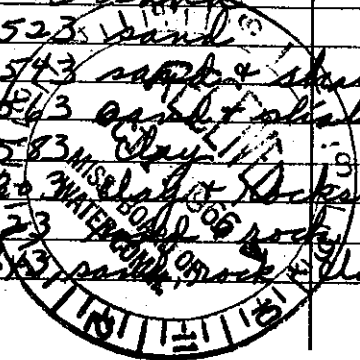

Mail this copy to Board of Water Commissioners 429 Miss. St. Jackson, Miss.

Cont'd

MISSISSIPPI BOARD OF WATER COMMISSIONERS

Coahoma Co. WATER WELL DRILLERS LOG

Date: Sept, 1966, Driller: Luther Ratliff County _____
 (When well drilled) (Name) (Where well is located)

(1) Owner of Land: <u>Kyle Co</u> (Name)	Description & Color of Materials Sand, Clay, Red Clay, Shell, etc.	Thick- ness Feet	Depth Feet
(Address)	<u>643-663 shale</u>		
(2) Location: _____ 1/4, _____ 1/4, Sec. _____ T _____ R _____	<u>663-683 sand</u>		
_____ miles _____ of _____ (distance) (direction) (Nearest Town)	<u>683-703 sand + clay</u>		
(3) Topography: _____ (Hilly) (Flat) (Level)	<u>703-723 sand</u>		
(4) Purpose of Well: _____ (Domestic Irrigation Municipal, Industrial, Other)	<u>723-743 sand</u>		
	<u>743-827 shale</u>		
	<u>827-847 sand</u>		
	<u>847-947 shale</u>		
	<u>947-987 sand</u>		
	<u>987-1007 shale</u>		
	<u>1007-1089 sand</u>		

Information upon completion of well:

- (1) Diameter 4x2 inches.
1089
- (2) Total Depth 743 feet.
- (3) Water Level Flowing feet below top of ground.
1069
- (4) Cased to 743, Size 4x2
- (5) Screen: Size 10 slot, Length 20'
- (6) Were any formations sealed against pollution?
_____ yes, _____ no.

If YES depth of formation _____


Why _____

Drillers Remarks: _____

Yield in gpm: 30

Size pump: 2 H.P.

Type power: Elec

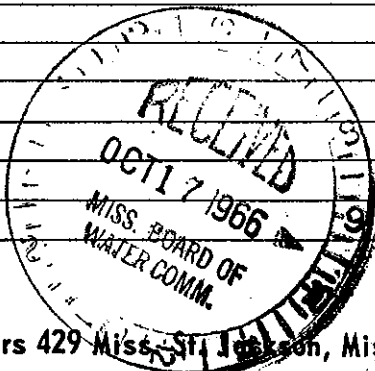

Mail this copy to Board of Water Commissioners 429 Miss. St. Jackson, Miss.