

Coahoma
Q42
3-5-80

MISSISSIPPI
BOARD OF WATER COMMISSIONERS
416 North State Street
Jackson, Mississippi 39201

CODED

WATER WELL DRILLERS LOG

3/5 1980 Dyer Coahoma
date well completed firm name county well located

LANDOWNER:
RUDOLPH SMITH
COAHOMA
(mailing address)

description of formations encountered

	from	to
Clay	0	13
FINE SAND	13	40
Coarse Sand & Gravel	40	113

WELL LOCATION:
sec. 27 T. 25 N. R. 3
4 miles S of Dublin
(distance) (direction) (nearest town)

WELL PURPOSE: Irrigation
(home, irrigation, municipal, industrial)

WELL COMPLETION DATA:

(1) diameter (inches) 1.6"

(2) total depth (feet) 113'

(3) static water level (feet) 22' below top of ground.

(4) casing Steel 113'
(material) (depth)

16" if telescope see back.
(size)

(5) screen 40' 73'
(length) (depth to top)

16" Steel
(size) (material)

(6) pump 60 3000
(HP) (yield gpm)


Diesel
(type power)

(7) electric log (yes or no)

(organization running log)

(8) how well bottom plugged plate

CODED

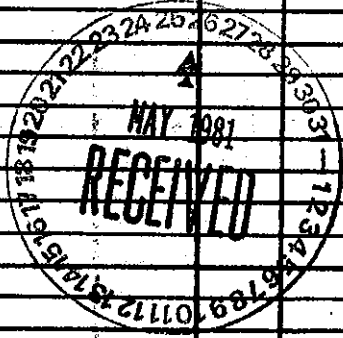

DRILLERS REMARKS: