

# State Well Report

## Part 1

Mississippi Department of Environmental Quality  
Office of Land and Water Resources  
P.O. Box 10631  
Jackson, MS 39289-0631  
(601)961-5210  
(601)354-6938 (fax)

For Office Use Only:

Aquifer: \_\_\_\_\_  
Well #: Q-87  
L. S. Elevation: \_\_\_\_\_  
E-log #: \_\_\_\_\_

County: Coahoma  
Permit #: \_\_\_\_\_  
Driller: Willie Bryant  
Date drilling completed: 3-19-05

State Law requires that this report be prepared by the driller in detail and filed with the Department within 30 days of completion of drilling of the well.

Well Owner Information	Well Location
Owner Name: <u>Antioch M.B. Church</u>	Latitude: <u>34° 03' 18" N</u> Longitude: <u>090° 30' 71" W</u>
Mailing Address: <u>3430 Dogwalk Rd.</u>	Method of Lat/Long (circle one): Conventional Survey, USGS quad, <u>Hand-held GPS</u> , Survey-grade GPS
<u>Dublin</u> MS <u>38739</u>	1/4 Sec <u>59</u> Twn <u>25 N</u> Rng <u>3 W</u>
City State Zip Code	Distance Direction Nearest Town
Telephone No. ( <u>662</u> ) <u>624-4452</u> <u>627-9764</u>	<u>1 1/4</u> Miles <u>west</u> of <u>Dublin</u>

**Well Data**

Purpose of Well (circle one) Home Industrial Public Supply Irrigation Fish Culture Other: Bathroom Use

Date well drilling started: 3-19-05 Date well drilling completed: 3-19-05

If flowing, method of flow regulation: Valve \_\_\_\_\_ Other (describe) \_\_\_\_\_

Static Water Level: 35' feet above or below (circle one) land surface Date measured: 3-19-05

Method of Measurement (circle one) steel tape electric tape air line other: rope & weight

Hole depth: 100' Well depth: 100' Well grouted to a depth of 25 feet

Type of grout (circle one): Cement Bentonite Mix

Casing length: 90' feet Casing diameter: 4" inches Type of casing: PVC 160

Screen length: 10' feet Screen diameter: 4" inches Type of screen: PVC SCH 40

Screen slot size: .013 inches Setting depth: From 90' feet to 100' feet

Type of completion (circle all applicable): Gravel packed Underreamed Telescoped Open hole Natural Development

Other (describe): \_\_\_\_\_

Top of lap pipe or reduction in casing: \_\_\_\_\_ feet. If telescoped or more than one screen, describe on back of page

Logs run (circle all applicable): No log run Electric Gamma Ray Density Sonic Neutron Other: \_\_\_\_\_

Name of organization running log(s): \_\_\_\_\_

I certify that the well was drilled, constructed, and completed in accordance with all applicable requirements of the Mississippi Department of Environmental Quality and/or the Mississippi Department of Health regulations and state laws.

Willie L. Bryant 0-639  
Print Name of Water Well Contractor and License No.

Willie L. Bryant  
Signature of Water Well Contractor

RECEIVED

APR 05 2005

BY: OLWR

no. 67

If well telescopes please sketch below and show depths.


Ground Level

Q-87

Description of Formations Encountered	From	To
Clay	0	20
Clay	20	40
Clay + Med. Sand	40	60
Coarse Sand	60	80
Coarse Sand + gravel	80	100

If more than one screen, show location of each on sketch

Sketch the property layout and include the following: 1) the well location; 2) any permanent structures on the property that may aid in locating the well; 3) any roads, power lines, or other items that may aid in locating the property and the well; 4) indicate direction.

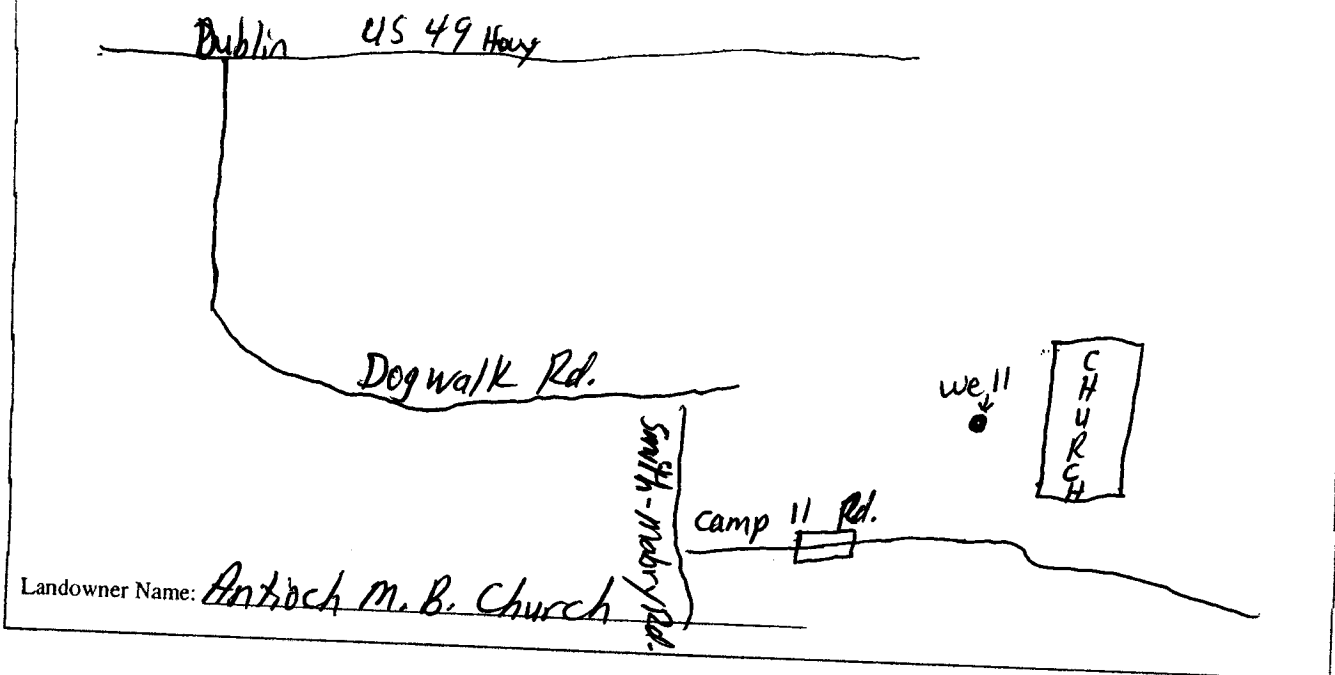

Landowner Name: Antioch M. B. Church

*Wilkie L. Bryant*  
Signature of Water Well Contractor

RECEIVED  
APR 05 2005  
BY: OLWR

NO. 67

# STATE WELL REPORT

## Part 2

**Pump Installer's Completion Report**  
 Mississippi Department of Environmental Quality  
 Office of Land and Water Resources  
 P.O. Box 10631  
 Jackson, MS 39289-0631  
 (601)961-5210  
 (601)354-6938 (fax)

For Office Use Only:

Aquifer: \_\_\_\_\_

Well #: Q-87

Elevation: \_\_\_\_\_

County: Coahoma

Permit #: \_\_\_\_\_

Driller: Willie L. Bryant

Date completed: 3-19-05

**This report should be prepared by the pump installer in detail and filed with the Department within 30 days of the installation of pump.**

Well Owner Information	Well Location
Owner Name: <u>Antioch M. B. Church</u>	Latitude: <u>34° 03.181 N</u> Longitude: <u>090° 30.714 W</u>
Mailing Address: <u>3430 Dog Walk Rd.</u>	Method of Lat/Long (circle one): Conventional Survey, _____
_____	USGS quad. <u>Hand-held GPS</u> Survey-grade GPS
<u>Dublin</u> <u>MS</u> <u>39739</u>	_____ 1/4 _____ 1/4 Sec <u>9</u> Twn <u>25 N</u> Rng <u>3 W</u>
City State Zip Code	Distance Direction Nearest Town
Telephone No. ( <u>662</u> ) <u>624-4452</u> <u>627-9764</u>	<u>1 1/4</u> Miles <u>west</u> of <u>Dublin</u>

Pump Type Circle one	Power Type Circle one
Air Lift Jet <input checked="" type="radio"/> <u>Submersible</u>	Diesel Engine Gasoline Engine Natural Gas
Bucket Piston Turbine	<input checked="" type="radio"/> <u>Electric Motor</u> Hand Tractor PTO
Centrifugal Rotary Flowing Well	Windmill Other (specify): _____
Other (specify): _____	Horse Power Rating of Motor: <u>1/2 hp</u>
Date Pump Installed: <u>3-19-05</u>	Setting Depth: <u>60'</u> feet
Rated Pump Capacity: <u>12</u> Gallons Per Minute	Number of Stages: <u>8</u>

Pump Test Data	Method of Measuring Water Level Circle one
Date Well Tested: <u>3-19-05</u>	Air Line Electric Measuring Line Steel Tape
Static Water Level (A): <u>35'</u> Feet Below Land Surface	Other (specify): <u>rope + weight</u>
Pumping Water Level (B): <del>37'</del> Feet Below Land Surface	For flowing well, measured shut in head: _____ feet
Drawdown [(B) - (A)]: <u>2'</u> Feet Below Land Surface	Well yielded <u>13</u> GPM with a drawdown of
Test Pumping Rate: <u>13</u> Gallons Per Minute	<u>2</u> feet after <u>5</u> hours of pumping
Duration of Pump Test (minimum 4 hours): <u>5</u> hours	

I HEREBY CERTIFY that the above statements are true to the best of my knowledge.

Willie L. Bryant 0-639 Willie L. Bryant  
 Print Name of Pump Installer and License No. (if applicable) Signature of Pump Installer

RECEIVED

APR 05 2005

BY: OLWR

10.67