County: Permit #: _/ Irrigo Driller:	Coah Coah Suration	oma <i>4//78</i> Equipment
Date drilling	g completed:	6-17-06

State Well Report

Part 1

Mississippi Department of Environmental Quality
Office of Land and Water Resources
P.O. Box 10631
Jackson, MS 39289-0631
(601)961-5210
(601)354-6938 (fax)

For Office Use Only:		
Aquifer:		
Well #:		
L. S. Elevation:		
E-log #:		

State Law requires that this report be prepared by the driller in detail and filed with the Department within 30 days of completion of drilling of the well.

Well Owner Information	Well Location
Omoga Plantation	Latitude: 34 •00 54 . 0" Longitude: 90 • 28 •08 . 4
Owner Name	Lantuce: 31.00 31.0 Longitude: 30.20 00.4
Mailing Address: Box 38	Method of Lat/Long (circle one): Conventional Survey,
	USGS quad, Hand-held GPS, Survey-grade GPS
	NE 1/4 NE 1/4 Sec 26 Twn 25N Rng 3W
Tunica MS 38676	
City State Zip Code	Distance Direction Nearest Town 7 Miles East of Roundaway
Telephone No. ()	
Well I	Data
December 11 (1) In the second of the control of the	
Purpose of Well (circle one) Home Industrial Public Supply	
Date well drilling started: $6-17-06$ Date w	vell drilling completed: 6-1/-06
If flowing, method of flow regulation: Valve Other (de	escribe)
Static Water Level:35 ' feet above or below (circle one) la	and surface Date measured: 6-17-06
Method of Measurement (circle one) steel tape electric tape	air line other:
Hole depth: 122 Well depth: 122	Well grouted to a depth of 10 feet
Type of grout (circle one): Cement Bentonite Mix	
Casing length: 82 feet Casing diameter: 16	inches Type of casing: PVC Sch. 40
Screen length: 40 feet Screen diameter: 16	inches Type of screen: PVC Sch. 40
Screen slot size: . 050 inches Setting depth: From 8	feet to 122 feet
Type of completion (circle all applicable): Gravel packed Under	reamed Telescoped Open hole Natural Development
Other (describe):	
Top of lap pipe or reduction in casing feet. If tele	escoped or more than one screen, describe on back of page
Logs run (circle all applicable): No log run Electric Gamma Ray	Density Sonic Neutron Other.
Name of organization running log(s):	
I certify that the well was drilled, constructed, and completed in a	ccordance with all applicable requirements of the Mississippi
Department of Environmental Quality and/or the Mississippi Dep	artment of Health regulations and state laws.
Irrigation Equipment Inc.	D+/m M
Print Name of Water Well Contractor and License No.	Falm IV Chic
a contract of the trois contractor and Livelia Ity.	

41178

JUL 18 2915

YMD JOINT WATER MANAGEMENT DISTRICT.

a ,	1	ven keport	For Office Use Only:	
County: Coahoma	Part 1 95		95	
Permit (F-1041178		nt of Environmental Quality	Aquifer:	
Irrigation Equipment	Office of Land and Water Resources		Well #: 0 - 94	
Driller:	ł	Box 10631	weit #.	
Date drilling completed: 6-17-06		MS 39289-0631	L. S. Elevation:	
Date drilling completed:)961-5210		
	(601)33	64-6938 (fax)	E-log #:	
State Law requires that this repo 30 days of completion of drilling	ort be prepared by the	driller in detail and filed w	ith the Department within	
Well Owner Informa		Well	Location	
Owner Name Omega Plant	ation			
Owner Name Office Plant	acton	Latitude: 34 •00 54.0	" Longitude: 90 • 28 • 08 • 4	
Mailing Address: Box 38	·	Latitude: 34 00 54.0" Longitude: 90 28 08.4 Sy Method of Lat/Long (circle one): Conventional Survey,		
		USGS quad, Hand-held	GPS, Survey-grade GPS	
		NE 14 NE 14 Sec 26	Twn 25N Rng 3W	
Tunica MS	38676			
City Stat	e Zip Code	Distance Direction	Nearest Town	
Telephone No. ()			of Roundaway	
Telephone Ito.				
	Well	Data		
Purpose of Well (circle one) Home Indu	•••	(Irrigation Fish Culture	Other:	
Date well drilling started: 6-17-	06 Date v	well drilling completed: 6-	17-06	
If flowing, method of flow regulation: Valv	ve Other (d	escribe)		
Static Water Level: 35 feet abo	ove or below (circle one) l	and surface Date measured:	6-17-06	
Method of Measurement (circle one)	electric tape	air line other:		
Hole depth: 122 Well dept	th: 122	Well grouted to a depth of 1	0 feet	
Type of grout (circle one): Cement	Bentonite Mix			
Casing length: 82 feet Casing	g diameter. 16	_inches Type of casing:	PVC Sch.40	
Screen length: 40 feet Screen	n diameter. 16	inches Type of screen:	PVC Sch.40	
Screen slot size: . 050 inches	Setting depth: From _8	feet to	122 feet	
Type of completion (circle all applicable):	Gravel packed Under	reamed Telescoped Open i	ole Natural Development	
	Other (describe):			
Top of lap pipe or reduction in casing:	feet. If tel	escoped or more than one scre	en, describe on back of page	
Logs run (circle all applicable): No log run	Electric Gamma Ray	Density Sonic Neutron C	ther:	
Name of organization running log(s):				
I certify that the well was drilled, constru	cted, and completed in a	ccordance with all annicable	conirements of the Mississippi	

Department of Environmental Quality and/or the Mississippi Department of Health regulations and state laws.

Irrigation Equipment Inc. Patrick M. Chism 0695

Print Name of Water Well Contractor and License No.

State Well Report

RECEIVED

Signature of Water Well Contractor


JUL 1 0 2006

BY OLWA

Ground Level

Description of Formations Encountered	From	То
Clay	0	_35
Clay Fine Sand Fine Sand/gravel Med. Sand/gravel	36	45
Fine Sand/gravel	46	50
Med. Sand/gravel	51	22
		<u> </u>
		
	——	
		-
		\vdash
		\vdash
		1
	 _	igsquare
		$\vdash \vdash \vdash$
		igsquare
		igsquare
	<u> </u>	\vdash
		1
	_	
		
	_l	

If more than one screen, show location of each on sketch

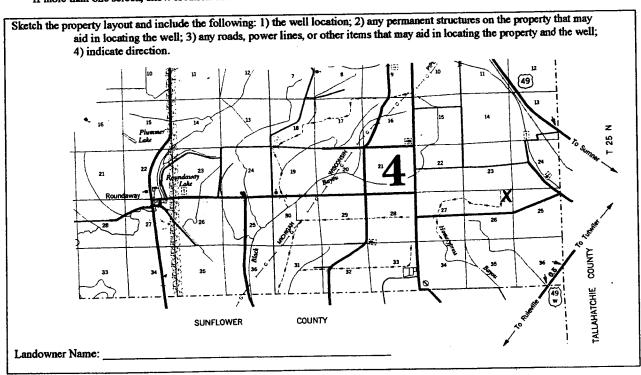

Signature of Water Well Contractor

STATE WELL REPORT

Part 2

County: Coahoma

Permit#: Mississippi Department of Environmental Quality
Office of Land and Water Resources
P.O. Box 10631
Jackson, MS 39289-0631
(601)961-5210
(601)354-6938 (fax)

For Offi	For Office Use Only:			
Aquifer:	95			
Well#: 4	- 34			
Elevation:				

Date completed: $6-17-06$	(601)961-5210 (601)354-6938 (fax)		Elevation:	
Copy information from block on Part 1 This part of the report must be completed by a	T	nterior or a licensed th	ump installer. A copy	of Part 1 of the
report must be attached and both parts juck w	ith the Department at t	he above address within	30 days of well comp Well Location	ction.
Well Owner Information				!
Owner Name: Omega Plantation		Latitude:		i i
Mailing Address: Box 38		Method of Lat/Long (ch		· ·
		USGS quad, Hand		
Tunica MS	38676	NE % NE % Se	<u>26 T25N</u>	₹ <u>3₩</u>
City State	Zip Code	Distance Direc	tion Nearest To	wn
Telephone No. ()		7 Miles Eas	t of Rounda	амау
			Power Type	
Pump Type Circle one			Circle one	
Air Lift let S	ubmersible	Diesel Engine	Gasoline Engine	Natural Gas
Bucket Piston	urbine	Electric Motor	Hand	Tractor PTO
Centrifugal Rotary F	lowing Well		Other (specify):	
Other (specify):		Horse Power Rating of	f Motor: 60	
Date Pump Installed: 6-17-0		Setting Depth:	70	fact
	allons Per Minute	Number of Stages:		
Pump Test Data		Metho	d of Measuring Water	r Levd
Date Well Tested:		Air Line Elec	tric Measuring Line	Steel Tape
Static Water Level (A):Feet B			,	
Pumping Water Level (B):Feet Bo		Other (specify):		
Drawdown [(B) – (A)]:Feet B		For flowing well, me	asured shut in head: _	feet
Test Pumping Rate:		Well yielded	GPM with	a drawdown of
Duration of Pump Test (minimum 4 hours):		fc	et after	hours of pumping
I HEREBY CERTIFY that the above statement	0695	Partie 1	11 Chi	
Print Name of Pump Installer and License N	o. (if applicable)	Signature o	f Pump Installer	Form: OLWR-SWR-1B

BY: OLIME