

County: Coahoma
 Permit #: GW43769
 Irrigation Equipment
 Driller: _____
 Date drilling completed: 1-14-10

State Well Report
Part 1 - Driller's Log

Mississippi Department of Environmental Quality
 Office of Land and Water Resources
 P.O. Box 2309
 Jackson, MS 39225
 (601)961-5210
 (601)961-5228 (fax)

For Office Use Only:
 Aquifer: 0116
 Well #: _____
 L. S. Elevation: _____
 E-log #: _____

State Law requires that this report be prepared by the license holder responsible for the work and filed with the Department at the above address within 30 days of completion of drilling of the well or borehole.

<p>Information on Well Owner (Landowner if borehole is not for a water well)</p> <p>Owner Name <u>Countess Belford</u> Mailing Address: <u>95 Bailey Ave.</u> <u>Coffeeville Ms. 38922</u> City State Zip Code Telephone No. <u>(662) 378-6031</u></p>	<p>Well or Borehole Location</p> <p>Latitude: <u>33.59.24"</u> Longitude: <u>90.32.49"</u> Method of Lat/Long (circle one): Conventional Survey, USGS quad, Hand-held GPS, Survey-grade GPS <u>SE 1/4 SW 1/4 Sec 31 Twn 25N Rng 3W</u> Distance Direction Nearest Town <u>4</u> Miles <u>NW</u> of <u>Rome</u></p>
--	--

Well / Borehole Data

Date drilling started: 1-14-10 Date drilling completed: 1-14-10 Hole depth: 127 Hole diameter: 24

Location of the source of any surface water used for drilling: Surface water
 Method of dosing and volume of Chlorine used in drilling and development: 50 ppm

Logs run (circle all applicable): No log run Electric Gamma Ray Density Sonic Neutron Other: _____
 Name of organization running log(s): _____

Purpose of borehole (check one): Water Well Geotechnical/Geological Investigation ___ Ground Source Heat Pump ___
 Seismic Survey ___ Other (describe) _____
If drilling is not related to water well construction, skip the remainder of this block

Purpose of Well (check one): Home ___ Industrial ___ Public Supply ___ Irrigation Fish Culture ___ Other: Replacement

If a flowing well, method of flow regulation: Valve ___ Other (describe) _____

Static Water Level: 44 feet above or below (circle one) land surface Date measured: 1-15-10

Method of Measurement (circle one) steel tape electric tape air line other: _____

Well depth: 127 Well grouted to a depth of 10 feet Type of grout (circle one): Neat Cement Bentonite Mix

Casing length: 87 feet Casing diameter: 16 inches Type of casing: PVC

Screen length: 40 feet Screen diameter: 16 inches Type of screen: PVC

Screen slot size: .050 inches Setting depth: From 88 feet to 127 feet

Type of completion (circle all applicable): Gravel packed Underreamed Telescoped Open hole Natural Development
 Other (describe): _____

Top of lap pipe or reduction in casing: _____ feet. *If telescoped or more than one screen, describe on next page*

Old Well 16" Steel 15' North


Form: OLWR-SWR-1A (04/08)

RECEIVED
 JAN 20 2010
 BY: OLWR

0116

The sketch below only required for water wells

If well telescopes, show depths on sketch.

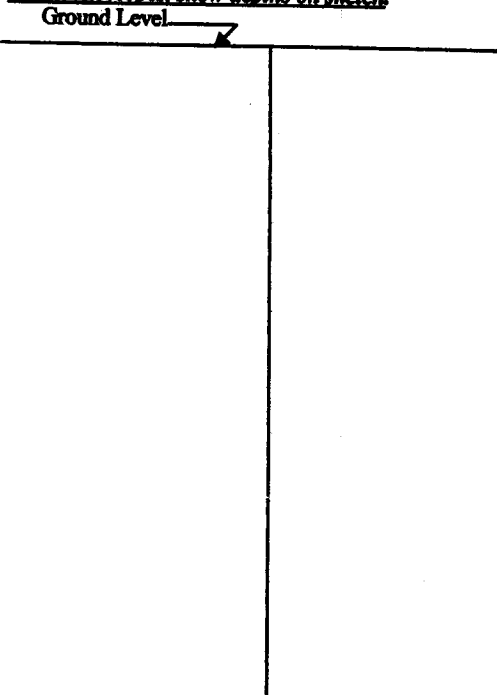

Description of formations encountered must be provided for all wells and boreholes, unless specifically exempted by regulations

Description of Formations Encountered	From (depth)	To (depth)
Clay	Ground Level	23
Fine Sand	24	39
Fine Sand + Gravel	40	64
Medium Sand + Gravel	65	127

If more than one screen, show location of each on sketch

Sketch the property layout and include the following: 1) the well location; 2) any permanent structures on the property that may aid in locating the well; 3) any roads, power lines, or other items that may aid in locating the property and the well; 4) a north arrow.

Landowner Name: Countess Belford

Form: OLWR-SWR-1A (04/08)

I certify that the well/borehole was drilled, constructed, and completed in accordance with all applicable requirements of the Mississippi Department of Environmental Quality and the Mississippi Department of Health regulations, if applicable, and state laws.

John P. Chism 0439

Signature of Licensee

Print Name of Responsible Licensee and License No. _____ Date _____

RECEIVED

BY: D/WE

STATE WELL REPORT

Part 2

Pump Installer's Completion Report
 Mississippi Department of Environmental Quality
 Office of Land and Water Resources
 P.O. Box 2309
 Jackson, MS 39225
 (601)961-5210
 (601)961-5228 (fax)

County: Coahoma
 Permit #: _____
Irrigation Equipment
 Driller: _____
 Date completed: 1-14-10
Copy information from block on Part 1

For Office Use Only:

Aquifer: 0116
 Well #: _____
 Elevation: _____

This part of the report must be completed by a licensed water well contractor or a licensed pump installer. A copy of Part 1 of the report must be attached and both parts filed with the Department at the above address within 30 days of well completion.

Well Owner Information	Well Location
Owner Name: <u>Countess Belford</u>	Latitude: _____ Longitude: _____
Mailing Address: <u>95 Bailey Ave.</u>	Method of Lat/Long (check one): Conventional Survey _____
<u>Coffeeville Ms. 38922</u>	USGS quad _____, Hand-held GPS _____, Survey-grade GPS _____
City State Zip Code	<u>SE 1/4 SW 1/4 Sec 31 T25N R 3W</u>
Telephone No. <u>(662) 378-6031</u>	Distance Direction Nearest Town
	<u>4 Miles NW of Rome</u>

Pump Type Circle one	Power Type Circle one
Air Lift Jet Submersible	<u>Diesel Engine</u> Gasoline Engine Natural Gas
Bucket Piston <u>Turbine</u>	Electric Motor Hand Tractor PTO
Centrifugal Rotary Flowing Well	Windmill Other (specify): _____
Other (specify): _____	Horse Power Rating of Motor: <u>60</u>
Date Pump Installed: <u>1-15-10</u>	Setting Depth: <u>70</u> feet
Rated Pump Capacity: <u>2800 ±</u> Gallons Per Minute	Number of Stages: <u>1</u>

Pump Test Data	Method of Measuring Water Level Circle one
Date Well Tested: _____	Air Line Electric Measuring Line Steel Tape
Static Water Level (A): _____ Feet Below Land Surface	Other (specify): _____
Pumping Water Level (B): _____ Feet Below Land Surface	For flowing well, measured shut in head: _____ feet
Drawdown [(B) - (A)]: _____ Feet Below Land Surface	Well yielded _____ GPM with a drawdown of _____ feet after _____ hours of pumping
Test Pumping Rate: _____ Gallons Per Minute	
Duration of Pump Test (minimum 4 hours): _____ hours	

I HEREBY CERTIFY that the above statements are true to the best of my knowledge.

John P. Chism 0439
 Print Name of Pump Installer and License No. (if applicable)

John P. Chism
 Signature of Pump Installer


Form: OLWR-SWR-1B (04/08)

RECEIVED

JAN 21 2010

BY: OLWR

0116

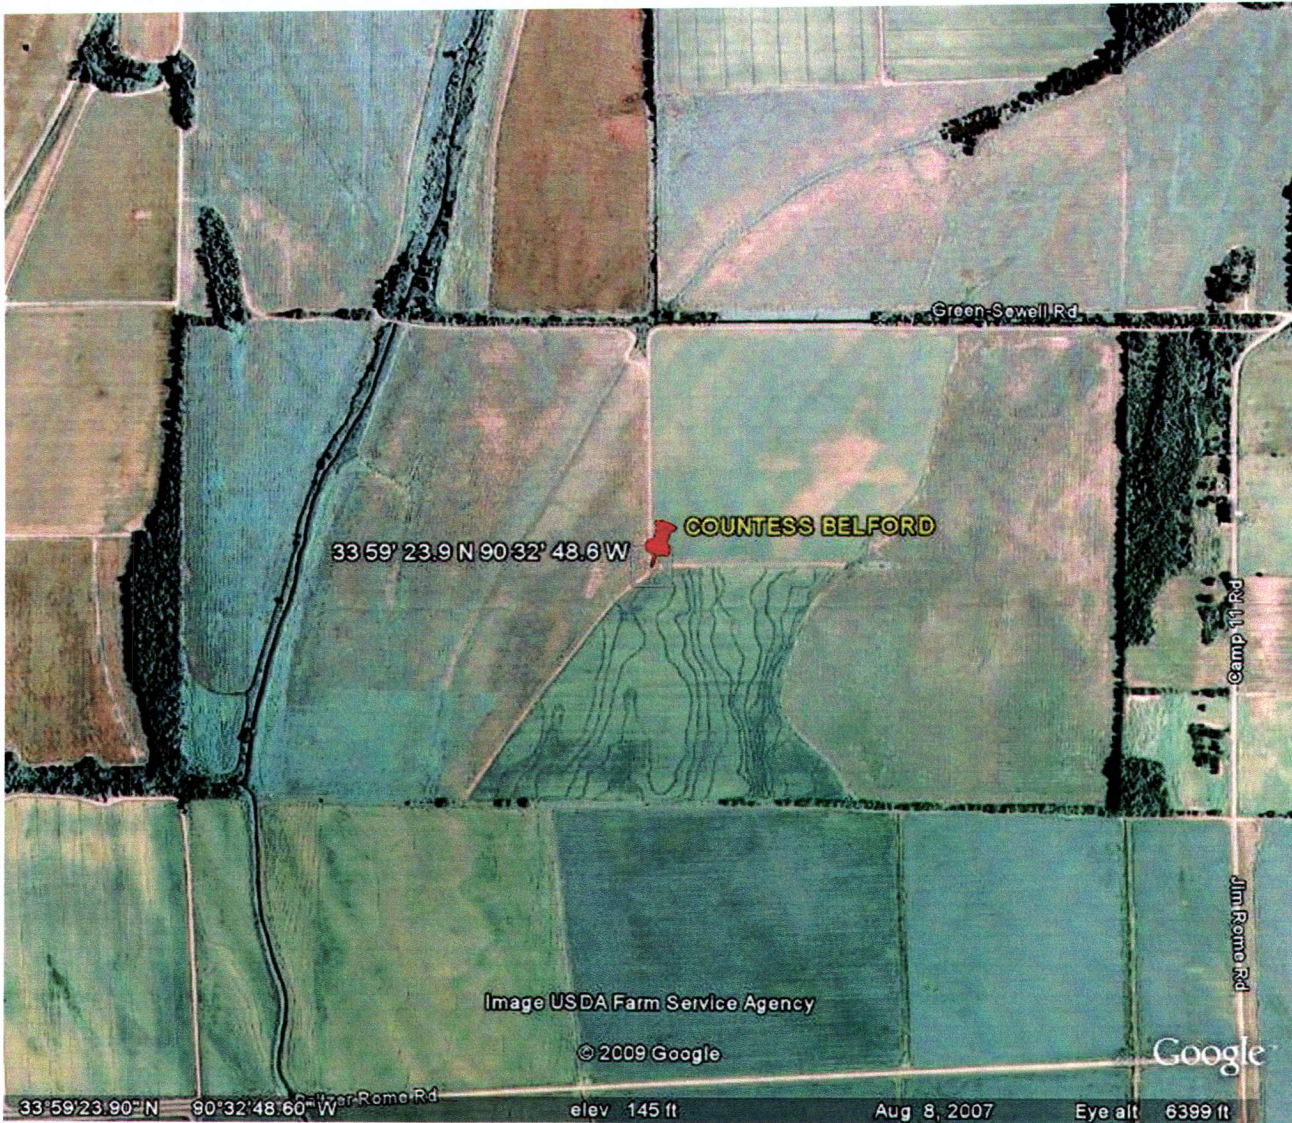

RECEIVED
JAN 28 2011
BY: OLWR