

County: Coahoma  
 Permit #: GLW-453731  
 Driller: Irrigation Equipment  
 Date drilling completed: 6-9-11

**State Well Report**  
**Part 1 - Driller's Log**  
 Mississippi Department of Environmental Quality  
 Office of Land and Water Resources  
 P.O. Box 2309  
 Jackson, MS 39225  
 (601)961- 5210  
 (601)961- 5228 (fax)

**For Office Use Only:**  
 Aquifer: 0132  
 Well #: \_\_\_\_\_  
 L. S. Elevation: \_\_\_\_\_  
 E-log #: \_\_\_\_\_

*State Law requires that this report be prepared by the license holder responsible for the work and filed with the Department at the above address within 30 days of completion of drilling of the well or borehole.*

<p><b>Information on Well Owner</b>          (Landowner if borehole is not for a water well)</p> <p>Owner Name <u>Omegs/Flowers</u>          Mailing Address: <u>P.O. Box 38</u>  <u>Vardaman Ms. 38878</u>          City State Zip Code          Telephone No. ( ) _____</p>	<p><b>Well or Borehole Location</b></p> <p>Latitude: <u>34° 03' 07.2"</u> Longitude: <u>90° 32' 50.1"</u>          Method of Lat/Long (circle one): Conventional Survey,          USGS quad, <u>Hand-held GPS</u>, Survey-grade GPS ✓  <u>SE 1/4 NW 1/4 Sec 7</u> Twn <u>25N</u> Rng <u>3W</u>          Distance Direction Nearest Town  <u>3</u> Miles <u>SW</u> of <u>Dublin</u></p>
---	--

**Well / Borehole Data**

Date drilling started: 6-9-11 Date drilling completed: 6-9-11 Hole depth: 121 Hole diameter: 24"

Location of the source of any surface water used for drilling: Surface Water  
 Method of dosing and volume of Chlorine used in drilling and development: 50 PPM

Logs run (circle all applicable): No log run Electric Gamma Ray Density Sonic Neutron Other: \_\_\_\_\_  
 Name of organization running log(s): \_\_\_\_\_

Purpose of borehole (check one): Water Well  Geotechnical/Geological Investigation \_\_\_\_\_ Ground Source Heat Pump \_\_\_\_\_  
 Seismic Survey \_\_\_\_\_ Other (describe) \_\_\_\_\_  
*If drilling is not related to water well construction, skip the remainder of this block*

Purpose of Well (check one): Home \_\_\_\_\_ Industrial \_\_\_\_\_ Public Supply \_\_\_\_\_ Irrigation  Fish Culture \_\_\_\_\_ Other: Replacement

If a flowing well, method of flow regulation: Valve \_\_\_\_\_ Other (describe) \_\_\_\_\_

Static Water Level: 43 feet above or below (circle one) land surface Date measured: 6-11-11

Method of Measurement (circle one) steel tape electric tape air line other: \_\_\_\_\_

Well depth: 121 Well grouted to a depth of 10 feet Type of grout (circle one): Neat Cement Bentonite Mix

Casing length: 81 feet Casing diameter: 16 inches Type of casing: PVC

Screen length: 40 feet Screen diameter: 16 inches Type of screen: PVC

Screen slot size: .050 inches Setting depth: From 82 feet to 121 feet

Type of completion (circle all applicable): Gravel packed Underreamed Telescoped Open hole Natural Development  
 Other (describe): \_\_\_\_\_

Top of lap pipe or reduction in casing: \_\_\_\_\_ feet. *If telescoped or more than one screen, describe on next page*


Old well 16" steel 30' west

0132

The sketch below only required for water wells

If well telescopes, show depths on sketch

Ground Level →

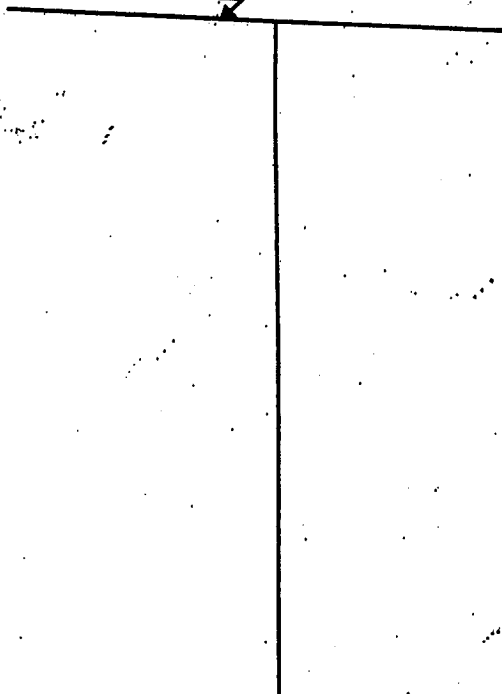

Description of formations encountered must be provided for all wells and boreholes, unless specifically exempted by regulations

Description of Formations Encountered	From (depth)	To (depth)
Clay	Ground Level	32
Flint Sand	33	38
Fine Sand + Gravel	39	77
Medium Sand + Gravel	78	121

If more than one screen, show location of each on sketch

Sketch the property layout and include the following: 1) the well location; 2) any permanent structures on the property that may aid in locating the well; 3) any roads, power lines, or other items that may aid in locating the property and the well; 4) a north arrow.

Landowner Name: Omega/Flowers

Form: OLWR-SWR-1A (04/08)

I certify that the well/borehole was drilled, constructed, and completed in accordance with all applicable requirements of the Mississippi Department of Environmental Quality and the Mississippi Department of Health regulations, if applicable, and state laws.

Patrick M. Chism 0695

Print Name of Responsible Licensee and License No.

Date

Signature of Licensee

County: Cochran  
 Permit #: GW-45373  
 Irrigation Equipment  
 Driller: \_\_\_\_\_  
 Date completed: 6-9-11  
 Carry information from block on Part 1

# STATE WELL REPORT

## Part 2

Pump Installer's Completion Report  
 Mississippi Department of Environmental Quality  
 Office of Land and Water Resources  
 P.O. Box 2309  
 Jackson, MS 39225  
 (601)961-5210  
 (601)961-5228 (fax)

For Office Use Only:  
 Aquifer: \_\_\_\_\_  
 Well #: Ø132  
 Elevation: \_\_\_\_\_

This part of the report must be completed by a licensed water well contractor or a licensed pump installer. A copy of Part 1 of the report must be attached and both parts filed with the Department at the above address within 30 days of well completion.

Well Owner Information	Well Location
Owner Name: <u>Omega / Flowers</u>	Latitude: _____ Longitude: _____
Mailing Address: <u>P.O. Box 38</u>	Method of Lat/Long (check one): Conventional Survey _____
<u>Vardaman</u> <u>MS</u> <u>38878</u>	USGS quad _____, Hand-held GPS <input checked="" type="checkbox"/> , Survey-grade GPS _____
City State Zip Code	<u>SE ¼ NW ¼ Sec 7 T 25N R 3W</u>
Telephone No. ( ) _____	Distance _____ Miles Direction _____ of Nearest Town <u>Dublin</u>

Pump Type	Power Type
Circle one	Circle one
Air Lift <input type="checkbox"/> Jet <input type="checkbox"/> Submersible <input type="checkbox"/>	<u>Diesel Engine</u> Gasoline Engine Natural Gas
Bucket <input type="checkbox"/> Piston <input type="checkbox"/> <u>Turbine</u>	Electric Motor <input checked="" type="checkbox"/> Hand _____ Tractor PTO
Centrifugal <input type="checkbox"/> Rotary <input type="checkbox"/> Flowing Well <input type="checkbox"/>	Windmill _____ Other (specify): _____
Other (specify): _____	Horse Power Rating of Motor: <u>125</u>
Date Pump Installed: <u>6-11-11</u>	Setting Depth: <u>70</u> feet
Rated Pump Capacity: _____ Gallons Per Minute	Number of Stages: <u>3</u>

Pump Test Data	Method of Measuring Water Level
Date Well Tested: _____	Circle one
Static Water Level (A): _____ Feet Below Land Surface	Air Line Electric Measuring Line Steel Tape
Pumping Water Level (B): _____ Feet Below Land Surface	Other (specify): _____
Drawdown [(B) - (A)]: _____ Feet Below Land Surface	For flowing well, measured shut in head: _____ feet
Test Pumping Rate: _____ Gallons Per Minute	Well yielded _____ GPM with a drawdown of _____ feet after _____ hours of pumping
Duration of Pump Test (minimum 4 hours): _____ hours	

This is for (circle one):     New Well     Replacement of Existing Pump     Repair of Existing Pump

I HEREBY CERTIFY that the above statements are true to the best of my knowledge.  
 Patrick M. Chism 0695  
 Print Name of Pump Installer and License No. (if applicable)      Patrick M. Chism  
 Signature of Pump Installer



Ø132



RECEIVED  
JUL 01 2011  
BY: OLWR