<u>t</u>		
County:	Coahoma	
	GW-4467	77 V
Driller:	Irrigation	Equipment
Date drilli	ng completed:	02/01/2012

State Well Report

Part 1 – **Driller's Log**Mississippi Department of Environmental Quality
Office of Land and Water Resources
P.O. Box 2309

Locker MS 20225

Jackson, MS 39225 (601) 961-5210 (601) 961-5228 (fax)

	For Office Use Only:
Aquifer:	<u> </u>
Well #:	
L.S. Eleva	ation:
E-log #:	

State Law requires that this report be prepared by the license holder responsible for the work and filed with the Department, at the above address within 30 days of completion of drilling of the well or borehole.

	Information on Well Owner	Well or Borehole Location
(Lando	wner if borehole is not for a water well)	
Owner Name	Vivien Eason	Latitude: 34 ° 02 ' 35 " Longitude: 90 ° 27 ' 52 "
Mailing Address:	P.O. Box 69	Method of Lat/Long (check one): Conventional Survey,
		☐ USGS quad, ☐ Hand-held GPS, ☐ Survey-grade GPS
	Dublin Ms 38739	NW 1/4 NW 1/4 Sec 13 / Twn 25N Rng 3W
	City State Zip code	Distance Direction Nearest Town
T-lbN-	4	
Telephone No.	(Miles Southeast of Dublin
	Well / Bo	orehole Data
Date drilling starte	ed: 02/01/2012 Date drilling completed: 02/0	01/2012 Hole depth: 123 Hole diameter: 18"
Location of the so	urce of any surface water used for drilling: Surface	Water
Method of dosing	and volume of Chlorine used in drilling and developm	ent: 50 PPM
	tion running log(e):	a Ray Density Sonic Neutron Other:
Purpose of boreho	le (check one): Water Well Geotechnical	//Geological Investigation Ground Source Heat Pump
	Seismic Survey Other (describe)
		nstruction, skip the remainder of this block
Purpose of Well (c	check one)	oply Irrigation Fish Culture Other:
If flowing, method	of flow regulation: Valve Other (de	scribe)
Static Water Level	: feet above or below (check one) 🔲 lar	nd ☐ surface Date measured:
Method of Measur	ement (check one) 🔲 steel tape 📋 electric tape	air line other:
		Type of grout (check one): Neat Cement Bentonite Mix
Casing length: _8	feet Casing diameter: 10	inches Type of casing: PVC
Screen length: _4	feet Screen diameter: 10	inches Type of screen: PVC
Screen slot size:	.050 inches Setting depth: From	84 feet to 123 feet
Type of completion	n (check all applicable): 🛛 Gravel packed 🔲 U	Inderreamed Telescoped Open hole Natural Development
	Other (describe):	
Top of lap pipe or	reduction in casing: feet. If	telescoped or more than one screen, describe on next page

Form: OLWR-SWR-1A (04/08)

RECEIVED

MAR 0 5 2012

BY: OLWR

ne	SACILA	UCIUN	Untry	<i>i cymu</i>	eu jui	PULL	mean.

T.	f wall	telesco	nec	chaw	denths	o#	sketch.
u	weu	IEIESCU	uco.	JRUN.	ucema	VII.	SPECIFIC.

Ground level		 	
	1		
	1		
	ľ		
	i		
	ŀ		

<u>Description of formations encountered must be provided for all wells and boreholes, unless specifically exempted by regulations</u>

Description of Formations Encountered	From (depth)	To (depth)
Clay	Ground level	22
Fine Sand	23	38
Fine Sand & Gravel	39	52
Medium Sand & Gravel	53	123

If more than one screen, show location of each on sketch

aid in I	out and include the following: 1) the well location; 2) any per ocating the well; 3) any roads, power lines, or other items that th arrow.	
Landowner Name:	Vivien Eason	
		Form: OLWR-SWR-1A (04/08)

I certify that the well/borehole was drilled, constructed, and completed in accordance with all applicable requirements of the Mississippi Department of Environmental Quality and the Mississippi Department of Health regulations, if applicable, and state laws.

Patrick Chism/Irrigation Equipment 0695

Print Name of Responsible Licensee and License No.

02/21/2012

RECEIVED

MAR 0 5 2012

BY: OLWR

STATE WELL REPORT

Part 2 **Pump Installer's Completion Report**

Mississippi Department of Environmental Quality Office of Land and Water Resources P.O. Box 2309 Jackson, MS 39225 (601) 961-5210 (601) 961-5228 (fax)

	For Office Use Only:	
Aquifer:		
Well #:	Ø134	
Elevation:	7	
Die vacion.		


Permit #: **GW-44677** Driller: Irrigation Equipment Date drilling completed: 02/01/2012 Copy information from block on Part 1

County: Coahoma

ort must be completed by a licensed water well contractor or a licensed nump installer. A copy of Part 1 of the

Well Owner Information	ı	Well Location
Owner Name: Vivien Eason		Latitude: 34 02' 35 N Longitude: 90 27' 52 W
Mailing Address: P.O. Box 69		Method of Lat/Long (check one): Conventional Survey,
	 	☐ USGS quad, ☐ Hand-held GPS, ☐ Survey-grade GPS
Dublin Ms City Sta		NW 1/4 NW 1/4 Sec 13 T 25N R 3W
City Sta	te Zip code	Distance Direction Nearest Town
Telephone No. () -		2 Miles Southeast of Dublin
Pump Type Check one		Power Type Check one
☐ Air Lift ☐ Jet 🖸	Submersible	☐ Diesel Engine ☐ Gasoline Engine ☐ Natural Gas
☐ Bucket ☐ Piston ☐] Turbine	☐ Electric Motor ☐ Hand ☐ Tractor PTO
Centrifugal Rotary	Flowing Well	☐ Windmill ☐ Other (specify):
Other (specify):		Horse Power Rating of Motor: 15
Date Pump Installed: Not set due to wet cond	litions	Setting Depth: 70 feet
Rated Pump Capacity 500+/-	Gallons Per Minute	Number of Stages: 1
Pump Test Data		Method of Measuring Water Level Check one
Date Well Tested:	····	☐ Air Line ☐ Electric Measuring Line ☐ Steel Tape
Static Water Level (A): Feet	Below Land Surface	Other (specify):
Pumping Water Level (B): Feet	Below Land Surface	
Drawdown [(B) - (A)]: Feet	Below Land Surface	For flowing well, measured shut in head: feet
Test Pumping Rate: C	Sallons Per Minute	Well yielded GPM with a drawdown of
Duration of Pump Test (minimum 4 hours):	hours	feet after hours of pumping
This is for (check one): New Well	Replacen	ment of Existing Pump Repair of Existing Pump
I HEREBY CERTIFY that the above statements as	re true to the best of m	ny knowledge.
		h 44)

MAR 0 5 2012

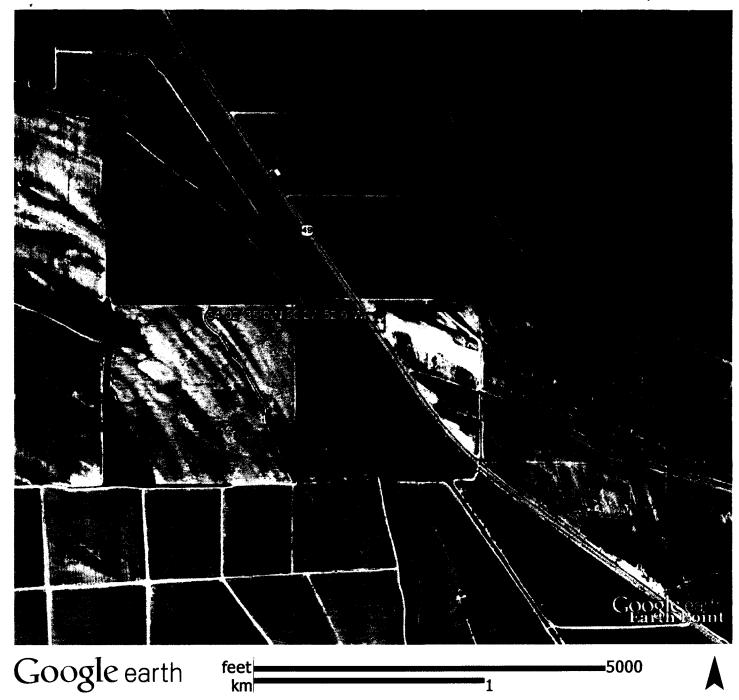

RECEIVED

MAR 0 5 2012

BY: OLWR