

# STATE WELL REPORT

## Part I

### Driller's Log

Mississippi Department of Environmental Quality  
 Office of Land and Water Resources  
 P.O. Box 2309  
 Jackson, MS 39225-2309  
 (601)961-5210  
 (601)360-0535 (fax)

### For Office Use Only:

Well #: 0153  
 Aquifer: \_\_\_\_\_  
 E-Log #: \_\_\_\_\_

County: Cozahoma  
 Permit #: GW-48238  
 Driller: Richard Foster  
 Date drilling completed: 4-24-14

State Law requires that this report be prepared by the license holder responsible for the work and filed with the Department at the above address within 30 days of completion of drilling of the well or borehole.

#3 Well Owner Information <u>1975</u> (Landowner if borehole is not for a water well)		Well or Borehole Location	
Owner Name: <u>Honey Family Trust</u>		Latitude: <u>34° 02' 12"</u> Longitude: <u>90° 31' 50"</u>	
Mailing Address: <u>P.O. Box 206</u>		Method of Lat/Long (check one): Conventional Survey _____,	
<u>Clarksdale</u> <u>MS</u> <u>38614</u> City State Zip Code		USGS quad _____, Hand-held GPS <input checked="" type="checkbox"/> , Survey-grade GPS _____	
Telephone No. <u>(662) 627-5501</u>		<u>SW 1/4 NE 1/4, Sec 17 T 25N R 03W</u> <u>6</u> Miles <u>NW</u> of <u>Rome</u> (Distance) (Direction) (Nearest Town)	

**Well / Borehole Data**

Date drilling started: 4-24-14 Date drilling completed: 4-24-14 Hole depth: 125' Hole diameter: 26"

Location of the source of any surface water used for drilling: Hauled water 1/2 mile

Method of dosing and volume of Chlorine used in drilling and development: \_\_\_\_\_

Logs run (circle all applicable):  No log run  Electric  Gamma Ray  Density  Sonic  Neutron  Other: \_\_\_\_\_

Name of organization running log(s): \_\_\_\_\_

Purpose of borehole (circle one):  Water Well  Geotechnical/Geological Investigation  Ground Source Heat Pump  
 Seismic Survey  Other (describe) \_\_\_\_\_

*If drilling is not related to water well construction, skip the remainder of this block*

Purpose of Well (circle all applicable): Home  Industrial  Public Supply   Irrigation  Fish Culture

Other (describe): \_\_\_\_\_

If a flowing well, method of flow regulation: Valve \_\_\_\_\_ Other (describe) N/A

Static Water Level: 44 feet (above or ~~below~~ land surface (circle one)) Date measured: 4-26-14

Method of measurement (circle one): Steel tape  ~~Electric tape~~ Air line  Other (describe): \_\_\_\_\_

Well depth: 125' Well grouted to a depth of: 10 feet Type of grout (circle one): ~~Neat Cement~~  Bentonite Mix

Casing length: 75 feet Casing diameter: 16 inches Type of casing: PVC

Screen length: 50 feet Screen diameter: 16 inches Type of screen: PVC

Screen slot size: .050 inches Setting depth: From 75 feet to 125 feet

Type of completion (circle all applicable):  Gravel packed  Underreamed  Open hole  Natural Development

Other (describe): \_\_\_\_\_

Top of lap pipe or reduction in casing: N/A feet


*If telescoped or more than one screen, describe on next page*

County: Coahoma  
 Permit #: GW-48238

For Office Use Only:  
 Well #: C153

The sketch below only required for water wells

If well telescopes, show depths on sketch.

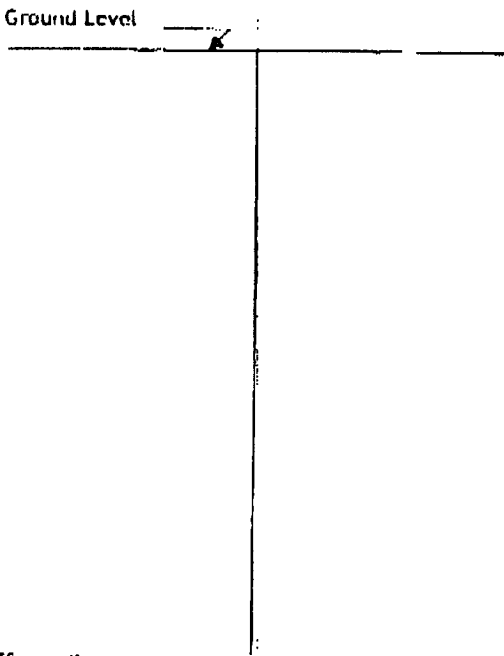


Description of formations encountered must be provided for all wells and boreholes, unless specifically exempted by regulations

Description of Formations Encountered	From (depth)	To (depth)
Top Soil	Ground level	12
Fine Sand	12	35
Medium Sand & Pea Gravel	35	89
Medium Sand & Pea Gravel	89	125

If more than one screen, show location of each on sketch

Sketch the property layout and include the following:

- 1) the well location
- 2) any permanent structures on the property that may aid in locating the well
- 3) any roads, power lines, or other items that may aid in locating the property and the well
- 4) north arrow

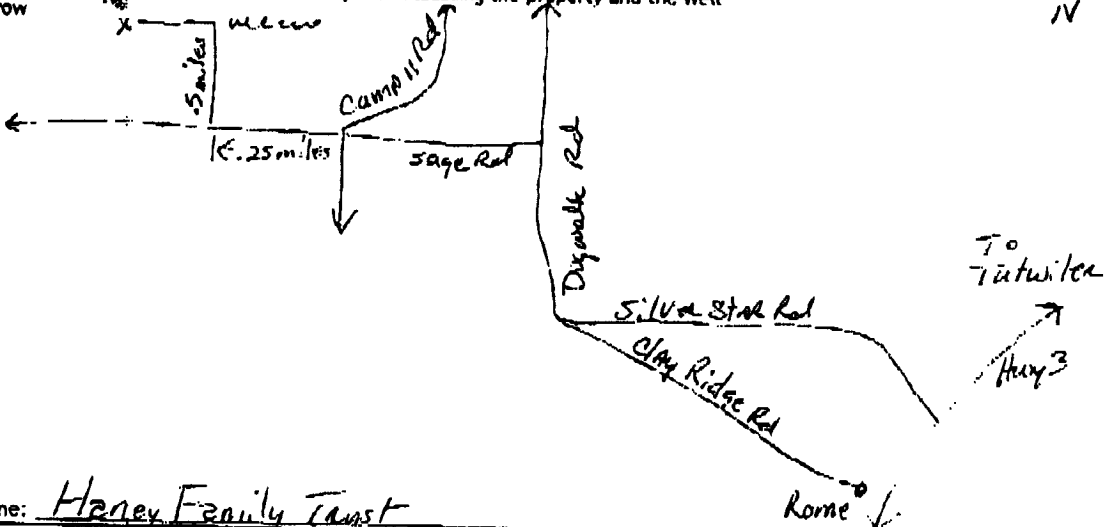

Landowner Name: Haney Family Trust

I HEREDY CERTIFY that the well/borehole was drilled, constructed, and completed in accordance with all applicable requirements of the Mississippi Department of Environmental Quality and the Mississippi Department of Health regulations, if applicable, and state laws.

Clayton Miller 0-203-4-28-14 Clayton Miller  
 Print Name of Responsible Licensee and License No. Date Signature of Licensee

### STATE WELL REPORT

#### Part 2

**Pump Installer's Completion Report**  
 Mississippi Department of Environmental Quality  
 Office of Land and Water Resources  
 P.O. Box 2309  
 Jackson, MS 39225-2309  
 (601)961-5210  
 (601) 360-0535 (fax)

#### For Office Use Only:

Well #: 0153  
 Aquifer: \_\_\_\_\_

County: Cochosoma  
 Permit #: BW-48238  
 Driller: John Rybolt II  
 Date completed: 4-26-14  
 Copy information from block on Part 1

*This part of the report must be completed by a licensed water well contractor or a licensed pump installer. A copy of Part 1 of the report must be attached and both parts filed with the Department at the above address within 30 days of well completion.*

Well Owner Information		Well Location	
Owner Name: <u>Honey Family Trust</u>		Latitude: <u>34° 02' 12"</u>	Longitude: <u>90° 31' 50"</u>
Mailing Address: <u>P.O. Box 206</u>		Method of Lat/Long (check one): Conventional Survey _____	
<u>Clarksdale</u>	<u>MS</u>	<u>38614</u>	USGS quad _____, Hand-held GPS <input checked="" type="checkbox"/> , Survey-grade GPS _____
City	State	Zip Code	<u>SW 1/4 NE 1/4, Sec 17 T 25N R 03W</u>
Telephone No. <u>(662) 622-5501</u>		<u>6</u> Miles <u>NW</u> of <u>Rome</u>	(Distance) (Direction) (Nearest Town)

**Pump Type (circle one)**

Submersible  Air Lift Centrifugal Flowing Well Jet Piston Rotary Other (describe): \_\_\_\_\_

Date Pump Installed: 4-26-14 Rated Pump Capacity: \_\_\_\_\_ Gallons Per Minute

Is This Pump (circle one):  New  Repaired  Replacement

**Power Type (circle one)**

Electric Diesel Gasoline Natural Gas Tractor PTO Windmill Other (describe): Bear Drive

Horse Power Rating of Motor: 60 Setting Depth: 80 feet Number of Stages: 1

**Pump Test Data for Non Flowing Well**

Date Well Tested: NOT TESTED Duration of Pump Test (minimum 4 hours): N/A hours

Static Water Level (A): 44 Feet Below Land Surface Pumping Water Level (B): N/A Feet Below Land Surface

Drawdown ((B) - (A)): N/A Feet Below Land Surface Test Pumping Rate: N/A Gallons Per Minute

Method of measurement (circle one): Steel tape  Electric tape  Air line Other (describe): \_\_\_\_\_

**Pump Test Data for Flowing Well**

Measured shut in head: \_\_\_\_\_ feet.

Well yielded \_\_\_\_\_ GPM with a drawdown of \_\_\_\_\_ feet after \_\_\_\_\_ hours of pumping

**Meter Installation**

Meter Manufacturer: \_\_\_\_\_ Meter Serial Number: \_\_\_\_\_

Meter Model Number/Name: \_\_\_\_\_ Type of Meter: \_\_\_\_\_

Totalizer Register Unit and Multiplier Factor (AF x .001, gal x 1000, etc): \_\_\_\_\_

Installation Date: \_\_\_\_\_ Meter installed by: \_\_\_\_\_

Is This Meter (circle one):  New  Repaired  Replacement

*Important: By submitting the above information you are certifying that this meter was installed to manufacturer standards. For agricultural wells, a list of approved meters is on the MDEQ website.*

I HEREBY CERTIFY that the above statements are true to the best of my knowledge.

Clayton Miller 0-703 4-28-14 Clayton Miller  
 Print Name of Pump Installer and License No. (if applicable) Date Signature of Pump Installer