

# STATE WELL REPORT

147

County: Coahoma  
 Permit #: 51262  
 Driller: Wes McMurry  
 Date drilling completed: 8-3-20

**Part 1**  
**Driller's Log**  
 Mississippi Department of Environmental Quality  
 Office of Land and Water Resources  
 P.O. Box 2309  
 Jackson, MS 39225-2309  
 (601)961-5555  
 (601)961-5228 (fax)

**For Office Use Only:**  
 Well #: 0178  
 Aquifer: \_\_\_\_\_  
 E-Log #: \_\_\_\_\_

*State Law requires that this report be prepared by the license holder responsible for the work and filed with the Department at the above address within 30 days of completion of drilling of the well or borehole.*

Well Owner Information <i>(Landowner if borehole is not for a water well)</i>	Well or Borehole Location
Owner Name: <u>Harry Family Trust</u>	Latitude: <u>33° 59' 24.31"</u> Longitude: <u>90° 31' 5.70"</u>
Mailing Address: <u>473 Dog Walk Rd</u>	Method of Lat/Long (check one): Conventional Survey _____
<u>Tutwiler MS 38963</u>	USGS quad _____, Hand-held GPS <input checked="" type="checkbox"/> , Survey-grade GPS _____
City State Zip Code	<u>NW 1/4 SW 1/4, Sec 33 T 25N R 04W</u> <sup>3W</sup>
Telephone No. <u>(662) 902-1824</u>	<u>5.3</u> Miles <u>SW</u> of <u>Tutwiler</u>
	(Distance) (Direction) (Nearest Town)

**Well / Borehole Data**

Date drilling started: 8-3-20 Date drilling completed: 8-3-20 Hole depth: 125 Hole diameter: 26"

Location of the source of any surface water used for drilling: ditch nearby

Method of dosing and volume of Chlorine used in drilling and development: \_\_\_\_\_

Logs run (check all applicable):  log run  Electric  Gamma Ray  Density  Sonic  Neutron Other: \_\_\_\_\_

Name of organization running log(s): \_\_\_\_\_

Purpose of borehole (check one): Water Well   Geotechnical/Geological Investigation  Ground Source Heat Pump  
 Seismic Survey Other (describe) \_\_\_\_\_

*If drilling is not related to water well construction, skip the remainder of this block*

Purpose of Well (check all applicable):  Home  Industrial  Public Supply  Irrigation  Fish Culture

Other (describe): \_\_\_\_\_

If a flowing well, method of flow regulation: Valve \_\_\_\_\_ Other (describe) \_\_\_\_\_

Static Water Level: 46 feet  above or  below land surface Date measured: 8-4-20  
 (check one)

Method of measurement (check one)  Steel tape  Electric tape  Air line  Other (describe): \_\_\_\_\_

Well depth: 125' Well grouted to a depth of: 10 feet Type of grout (check one)  Neat Cement  Bentonite  Mix

Casing length: 75 feet Casing diameter: 16 inches Type of casing: Pvc

Screen length: 50 feet Screen diameter: 16 inches Type of screen: Pvc

Screen slot size: .050 inches Setting depth: From 75 feet to 125 feet

Type of completion (check all applicable)  gravel packed  Underreamed  Open hole  Natural Development

Other (describe): \_\_\_\_\_

Top of lap pipe or reduction in casing: \_\_\_\_\_ feet

RECEIVED  
 AUG 13 2020  
 BY OLWR


*If telescoped or more than one screen, describe on next page*  
 Replacement Well

County: Coahoma  
Permit #: 51262

For Office Use Only:  
Well #: \_\_\_\_\_

The sketch below only required for water wells

If well telescopes, show depths on sketch.

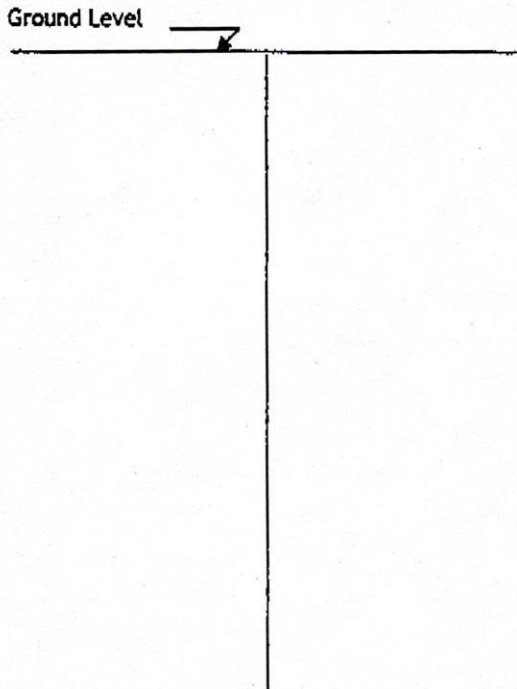


Description of formations encountered must be provided for all wells and boreholes, unless specifically exempted by regulations

Description of Formations Encountered	From (depth)	To (depth)
Top Soil / Clay	Ground level	15
Clay + Fine Sand	15	25
Fine Sand	25	35
Med. Sand	35	45
Med. / Coarse Sand	45	55
Med. / Coarse Sand	55	65
Coarse Sand	65	75
Coarse Sand / Pea gravel	75	85
Coarse Sand / Pea gravel	85	95
Coarse Sand / Pea gravel	95	105
Med / Coarse Sand / Pea gravel	105	115
Coarse Sand / Pea gravel	115	125

If more than one screen, show location of each on sketch

Sketch the property layout and include the following:

- 1) the well location
- 2) any permanent structures on the property that may aid in locating the well
- 3) any roads, power lines, or other items that may aid in locating the property and the well
- 4) north arrow

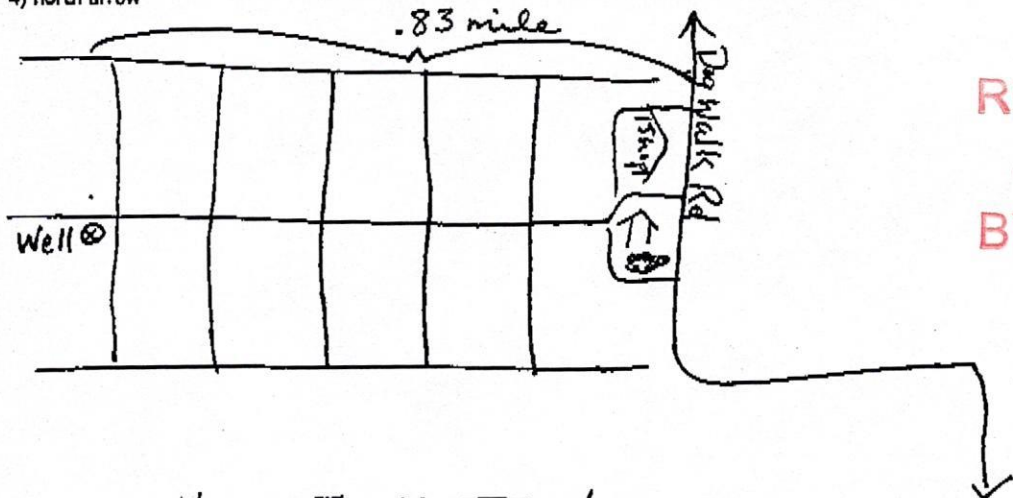

RECEIVED  
AUG 13 2020  
BY OLWR

Landowner Name: Haney Family Trust

I HEREBY CERTIFY that the well/borehole was drilled, constructed, and completed in accordance with all applicable requirements of the Mississippi Department of Environmental Quality and the Mississippi Department of Health regulations, if applicable, and state laws.

Peyton Overstreet 00008026 8-13-20 Peyton Overstreet  
Print Name of Responsible Licensee and License No. Date Signature of Licensee

### STATE WELL REPORT

#### Part 2

**Pump Installer's Completion Report**  
 Mississippi Department of Environmental Quality  
 Office of Land and Water Resources  
 P.O. Box 2309  
 Jackson, MS 39225-2309  
 (601)961-5210  
 (601) 360-0535 (fax)

County: Coahoma  
 Permit #: 51262  
 Driller: Wes McMurry  
 Date completed: 8-3-20  
*Copy information from block on Part 1*

**For Office Use Only:**  
 Well #: 0178  
 Aquifer: \_\_\_\_\_

*This part of the report must be completed by a licensed water well contractor or a licensed pump installer. A copy of Part 1 of the report must be attached and both parts filed with the Department at the above address within 30 days of well completion.*

<b>Well Owner Information</b>		<b>Well Location</b>	
Owner Name: <u>Haney Family Trust</u>		Latitude: <u>33°59'29.31"</u> Longitude: <u>90°31'5.70"</u>	
Mailing Address: <u>473 Dog Walk Rd</u>		Method of Lat/Long (check one): Conventional Survey _____, USGS quad _____, Hand-held GPS <input checked="" type="checkbox"/> , Survey-grade GPS _____	
<u>Tutwiler</u> MS <u>38963</u>	City State Zip Code	<u>NW 1/4 SW 1/4, Sec 33 T 25N R 04W</u> <sup>SW</sup>	
Telephone No. <u>(662) 902-1824</u>		<u>5.3</u> Miles <u>SW</u> of <u>Tutwiler</u> (Distance) (Direction) (Nearest Town)	

**Pump Type (check one)**

Submersible  Turbine  Air Lift  Centrifugal  Flowing Well  Jet  Piston  Rotary  Other (describe): \_\_\_\_\_

Date Pump Installed: 8-4-20 Rated Pump Capacity: 2400 Gallons Per Minute

Is This Pump (check one):  New  Repaired  Replacement

**Power Type (check one)**

Electric  Diesel  Gasoline  Natural Gas  Tractor PTO  Windmill  Other (describe): \_\_\_\_\_

Horse Power Rating of Motor: \_\_\_\_\_ Setting Depth: \_\_\_\_\_ feet Number of Stages: \_\_\_\_\_

**Pump Test Data for Non Flowing Well**

Date Well Tested: NOT TESTED Duration of Pump Test (minimum 4 hours): N/A hours

Static Water Level (A): 96 Feet Below Land Surface Pumping Water Level (B): N/A Feet Below Land Surface

Drawdown [(B) - (A)]: N/A Feet Below Land Surface Test Pumping Rate: N/A Gallons Per Minute

Method of measurement (check one): Steel tape  Electric tape  Air line  Other (describe): \_\_\_\_\_

**Pump Test Data for Flowing Well**

Measured shut in head: \_\_\_\_\_ feet.

Well yielded \_\_\_\_\_ GPM with a drawdown of \_\_\_\_\_ feet after \_\_\_\_\_ hours of pumping

**Meter Installation**

Meter Manufacturer: \_\_\_\_\_ Meter Serial Number: \_\_\_\_\_

Meter Model Number/Name: \_\_\_\_\_ Type of Meter: \_\_\_\_\_

Totalizer Register Unit and Multiplier Factor (AF x .001, gal x 1000, etc): \_\_\_\_\_

Installation Date: \_\_\_\_\_ Meter installed by: \_\_\_\_\_

Is This Meter (check one):  New  Repaired  Replacement

*Important: By submitting the above information you are certifying that this meter was installed to manufacturer standards. For agricultural wells, a list of approved meters is on the MDEQ website.*

RECEIVED  
 AUG 13 2020  
 BY OLWR

I HEREBY CERTIFY that the above statements are true to the best of my knowledge.

Payton Overstreet 80008026 8-13-20 Payton Overstreet  
 Print Name of Pump Installer and License No. (if applicable) Date Signature of Pump Installer