

CODED
112

A 2
9-24-62

WATER WELL DRILLERS LOG

Date: Sept 24, 19 62, Driller: Burney Water Well Serv. County Copiah
(Name)

(1) Owner of Land: F. A. Strong
(Name)
Carpenter, Miss.
(Address)
Highway 18
(2) Location: 1/4, 1/4, Sec. 2 T12R5
1 miles North of Carpenter
(distance) (direction) (Nearest Town)
(3) Topography: Level
(Hilly) (Flat) (Level)
(4) Purpose of Well: Domestic
(Domestic Irrigation
Municipal, Industrial, Other)

Description & Color of Materials Sand, Clay, Red Clay, Shell, etc.	Thick- ness Feet	Depth Feet
Topsoil	18	18
White sand	2	20
Pea gravel & sand	7	27
Clay & sand layers	36	63
Hard blue clay	32	95
Med. to fine sand & pea gravel	8	103


Information upon completion of well:

(1) Diameter 4 inches.
(2) Total Depth 103 feet.
(3) Water Level 20 feet below top of
ground.
(4) Cased to 96', Size 2"
(5) Screen: Size 2 1/2", Length 5'
(6) Were any formations sealed against pollution?
x yes, no.

If YES depth of formation Sealed from
Surface to prevent pollution
Why 58' 4" casing used from
surface

Drillers Remarks:

CODED

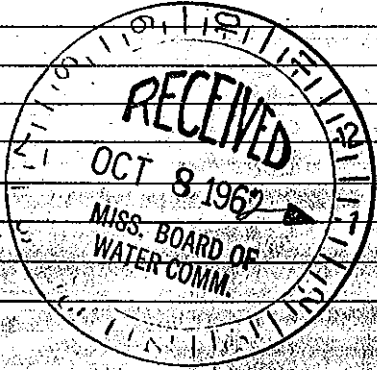

(Use Back Side)