

MISSISSIPPI BOARD OF WATER COMMISSIONERS

A 7  
3-17-64


WATER WELL DRILLERS LOG

MGS 13  
A7

Date: March 17, 1964, Driller: Burney Water Well Serv. County Copiah  
(Name)

CODED

	Description & Color of Materials Sand, Clay, Red Clay, Shell, etc.	Thick- ness Feet	Depth Feet
(1) Owner of land: <u>Hubert Little</u> (Name)	Topsoil & sand	12	12
Carpenter, Miss. (Address)	Pea gravel & sand	12	24
(2) Location: <u>Highway 18</u> <u>SE 1/4, 1/4, Sec. 11 T12R5</u> <u>in Carpenter, Miss.</u> miles, of (distance) (direction) (Nearest Town)	Blue clay	23	47
(3) Topography: <u>Flat</u> (Hilly) (Flat) (Level)	Layers of Limestone	11	58
(4) Purpose of Well: <u>Domestic</u> (Domestic Irrigation Municipal, Industrial, Other)	Blue shale	40	98
Information upon completion of well:	Sand layers	6	104
(1) Diameter <u>4</u> inches.	Good sand	6	110
(2) Total Depth <u>122</u> feet.	Fine tight sand	12	122
(3) Water Level <u>2</u> feet below top of ground.	Elev. <u>170' Tape</u>		
(4) Cased to <u>105'</u> , Size <u>2"</u>			
(5) Screen: Size <u>2 1/8"</u> , Length <u>5'</u>			
(6) Were any formations sealed against pollution? <u>X</u> yes, <u>      </u> no.			
If YES depth of formation <u>From surface</u>			
Why to prevent surface pollution			
Drillers Remarks: <u>Cemented at 24' from</u> <u>surface</u>			

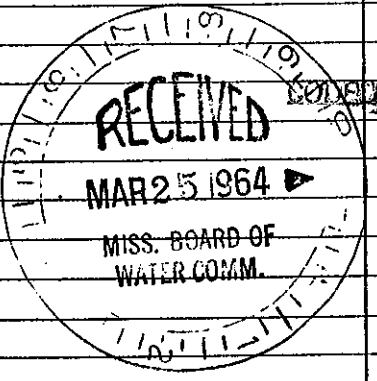

Well No.

(Use Back Side)

Mail this copy to Board of Water Commissioners 429 Miss. St. Jackson, Miss