

B7

COPIAH
~~B6~~

7-25-66

MISSISSIPPI BOARD OF WATER COMMISSIONERS

WATER WELL DRILLERS LOG

CODED

Inc.

Date: July 25, 1966, Driller: Burney Water Well Service County Copiah

(Name)

(1) Owner of Land: J. D. Hood
(Name)
P. O. Box 187
(Address)

(2) Location: 1/4, 22 3/4 Sec 24
Cooper Place
10 miles west of C. S.
(distance) (direction) (Nearest Town)

(3) Topography: Hilly
(Hilly) (Flat) (Level)

(4) Purpose of Well: Domestic
(Domestic Irrigation
Municipal, Industrial, Other)

Description & Color of Materials Sand, Clay, Red Clay, Shell, etc.	Thick- ness Feet	Depth Feet
Hard grey & yellow buckshot	19	19
Sand & pea gravel	10	29
Shale	3	32
Blue Sand	4	36
Blue shale	11	47
Rock or limestone	15	62
Blue Shale	35	97
Hard rock	1	98
Rock & or Limestone	27	125
Sand & rock layers	13	138
Hard rock	4	142
All med. sand	5	147
Fine sand	3	150
Gumbo clay	7	157

Information upon completion of well:

(1) Diameter 4 inches.

(2) Total Depth 157 feet.

(3) Water Level 36 feet below top of ground.

(4) Cased to 143', Size 4"

(5) Screen: Size 4", Length 10'


(6) Were any formations sealed against pollution?
 yes, no.

If YES depth of formation From surface

Why To prevent surface pollution

Drillers Remarks Sanitary well seal used

CODED

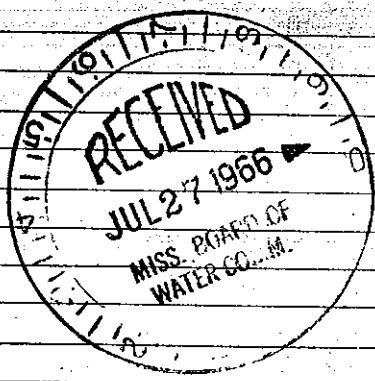

Well No.

(Use Back Side)

Mail this copy to Board of Water Commissioners 429 Miss. St. Jackson, Miss.