

**COPIAH MISSISSIPPI BOARD OF WATER COMMISSIONERS**

**B** 2007  
1-31-62

**WATER WELL DRILLERS LOG**

Date: Jan. 31, 19 62, Driller: Burney Water Well Serv County Copiah

(Name)

(1) Owner of Land: Daniel D. Scott

(Name)

Dentville, Miss.

(Address)

(2) Location: 1/4 Sec. 10 6E T. 12N R. 4W

1 miles North of Dentville  
(distance) (direction) (Nearest Town)

(3) Topography: Hilly

(Hilly) (Flat) (Level)

(4) Purpose of Well: Domestic

(Domestic Irrigation  
Municipal, Industrial, Other)

Description & Color of Materials Sand, Clay, Red Clay, Shell, etc.	Thick- ness Feet	Depth Feet
Topsoil & clay	12	12
Blue clay	28	40
Rock	1	41
Blue clay	15	56
Layers fine sand	12	68
all fine sand	12	80
All med. sand	18	98
Shale	4	102

Information upon completion of well:

(1) Diameter: 4 inches.

(2) Total Depth: 102 feet.

(3) Water Level: 60 feet below top of ground

(4) Cased to: 85' Size: 2"

(5) Screen: Size: 2" Length: 5'


(6) Were any formations sealed against pollution?

yes,  no.

If YES depth of formation: From surface

Why prevent surface pollution:

Drillers Remarks: Chlorinated

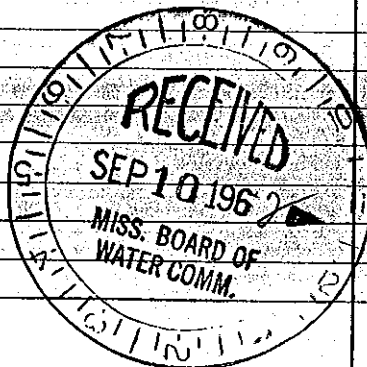

(Use Back Side)

Well No.

Mail this copy to Board of Water Commissioners 429 Miss. St. Jackson, Miss