

COPIAH

MISSISSIPPI BOARD OF WATER COMMISSIONERS

B 2002

4-14-66

WATER WELL DRILLERS LOG

Date: April 14, 1966, Driller: Burney Water Well Serv., Inc., County: Copiah

(Name)

(1) Owner of Land: John H. Raney (Name)

Rt. 1 Carpenter, Miss. (Address)

(2) Location: 1/4 Sec 25 2N 4W

1 1/2 miles North of Dentville (distance) (direction) (Nearest Town)

(3) Topography: Hilly (Hilly) (Flat) (Level)

(4) Purpose of Well: Domestic (Domestic Irrigation) (Municipal, Industrial, Other)

Description & Color of Materials Sand, Clay, Red Clay, Shell, etc.	Thick- ness Feet	Depth Feet
Top soil & grey clay	30	30
Blue & Brown clay	26	56
Layers of fine sand	16	72
Blue shale	12	84
Fine sand in layers	19	103
All fine sand	6	109
Blue clay	3	112
Fine sand	11	123
All good sand	21	144

Information upon completion of well:


- (1) Diameter 4 1/2 inches.
- (2) Total Depth 144 feet.
- (3) Water Level 49 feet below top of ground.
- (4) Cased to 131', Size 2
- (5) Screen: Size 2 1/8", Length 5'
- (6) Were any formations sealed against pollution?
 yes, no.

If YES depth of formation From surface

Why to prevent surface pollution

Drillers Remarks: Sanitary well seal.

used.

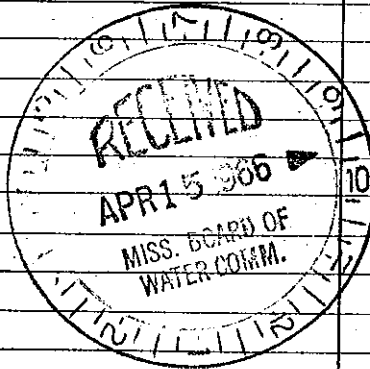

(Use Back Side)

Well No.

Mail this copy to Board of Water Commissioners 429 Miss. St. Jackson, Miss.