

**COPIAH MISSISSIPPI BOARD OF WATER COMMISSIONERS**

**1-5-65**

**WATER WELL DRILLERS LOG**

Date: Jan 5, 1965, Driller: Burney Water Well Serv. County Copiah  
(Name)

(1) Owner of Land: Ely Ford  
(Name)  
Route 3, Box 90, Crystal Springs  
(Address)  
Dentville Road 15 2 3 W  
(2) Location: 1/4, 1/4, Sec. T R,  
6 1/2 miles SW of Crystal Springs  
(distance) (direction) (Nearest Town)  
(3) Topography: Hilly  
(Hilly) (Flat) (Level)  
(4) Purpose of Well: Domestic  
(Domestic Irrigation  
Municipal, Industrial, Other)

Description & Color of Materials Sand, Clay, Red Clay, Shell, etc.	Thick- ness Feet	Depth Feet
Red clay topsoil	12	12
Red sand	4	16
Sand & gravel	5 1/2	70
Iron rock in layers	9	79
Hard grey rock	3	82
Hard blue clay	23	105
Sand in layers	5	110
Sand in layers, fine to med.	13	123
All blue clay	23	140

Information upon completion of well:

(1) Diameter 4 inches.

(2) Total Depth 140 feet.


(3) Water Level 88 feet below top of ground.

(4) Cased to 11 1/4', Size 2"

(5) Screen: Size 2 1/8", Length 5'

(6) Were any formations sealed against pollution?  
 yes,  no.

If YES depth of formation from surface \_\_\_\_\_  
Why to prevent surface pollution \_\_\_\_\_  
Drillers Remarks: \_\_\_\_\_

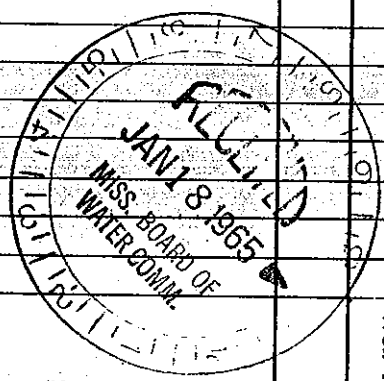

Well No. \_\_\_\_\_

(Use Back Side)

Mail this copy to Board of Water Commissioners 429 Miss. St. Jackson, Miss.