

COPIAH MISSISSIPPI BOARD OF WATER COMMISSIONERS

C5
6-4-63

WATER WELL DRILLERS LOG

CODED

M65
C5

Date: June 4, 1963, Driller: Ben Burney County: Copiah

(Name)

(1) Owner of Land: Wilbur Sumerall
(Name)

Route 3, Crystal Springs, Miss.
(Address)

Dentville Road
(Address)

(2) Location: SE 1/4 NE 1/4, Sec. 34 T2 R3

9 miles West of Cryst. Spgs.
(distance) (direction) (Nearest Town)

(3) Topography: Hilly
(Hilly) (Flat) (Level)

(4) Purpose of Well: Domestic
(Domestic Irrigation, Municipal, Industrial, Other)

Information upon completion of well:

(1) Diameter 4 inches.

(2) Total Depth 122 feet.

(3) Water Level 84 feet below top of ground.

(4) Cased to 122', Size 2"

(5) Screen: Size 2 1/2", Length 5'

(6) Were any formations sealed against pollution?


yes, no.

If YES depth of formation From Surface

Why to prevent surface pollution

Drillers Remarks:

Description & Color of Materials Sand, Clay, Red Clay, Shell, etc.	Thick- ness Feet	Depth Feet
Topsoil & White Clay	10	10
Rock	4	14
Grey Clay	5	19
Rock	3	22
Grey Clay	13	35
Sand in layers	8	43
Yellow & Grey Clay	4	47
Rock (Hard)	2	49
Blue Clay	26	75
Soft Blue Clay	27	102
Layers of Sand	7	109
All good Sand	13	122

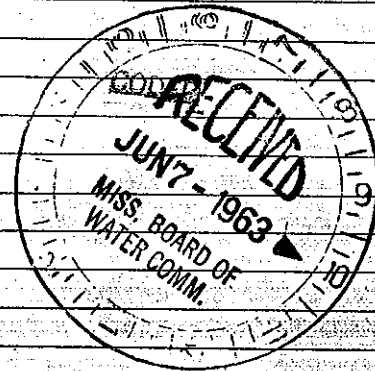

Elev 335' Top

Well No.

(Use Back Side)

Mail this copy to Board of Water Commissioners 429 Miss. St. Jackson, Miss.