

COPIAH MISSISSIPPI BOARD OF WATER COMMISSIONERS

807
11-13-64

WATER WELL DRILLERS LOG

CODED

MGS
07

Date: November 13, 1964, Driller: BURNEY WATER WELL SERV County Copiah

(Name)

(1) Owner of Land: <u>Charles O. Simmons</u> <small>(Name)</small>	Description & Color of Materials Sand, Clay, Red Clay, Shell, etc.	Thick- ness Feet	Depth Feet
Rt. 1, Box 190, Utica, Miss. <small>(Address)</small>	Red top soil	4	4
<small>(Jack community)</small>	Red sand and gravel	46	50
(2) Location: <u>SW 1/4, SE 1/4, Sec. 6, T. 2 S.</u>	Blue clay	46	96
<u>1 1/2</u> miles <u>West</u> of <u>Crystal Springs</u> <small>(distance) (direction) (Nearest Town)</small>	Soft grey formation	16	112
(3) Topography: <u>Hilly</u> <small>(Hilly) (Flat) (Level)</small>	Yellow & grey sand	26	138
(4) Purpose of Well: <u>Domestic</u> <small>(Domestic Irrigation Municipal, Industrial, Other)</small>	gs. Fine grey sand	42	180
	Sharp sand	6	186
	Good sharp blue sand	20	206
	Medium to coarse sand	16	222

Information upon completion of well:

- (1) Diameter 6" inches.
- (2) Total Depth 222' feet.
- (3) Water Level 151' feet below top of ground.
- (4) Cased to 207', Size 4"
- (5) Screen: Size 2 1/2", Length 10'
- (6) Were any formations sealed against pollution?
X yes, no.


If YES depth of formation 8' from surface

Why To prevent surface pollution

Drillers Remarks:

Elev. 316' Topo.

CODED

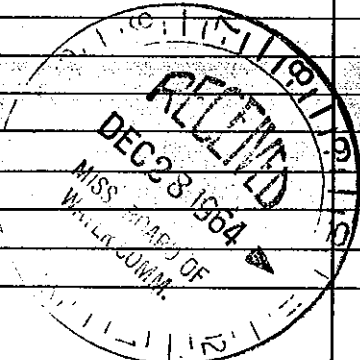

(Use Back Side)

Well No.

Mail this copy to Board of Water Commissioners 429 Miss. St. Jackson, Miss.