

COPIAH

MISSISSIPPI BOARD OF WATER COMMISSIONERS

C 10

4-1-66

WATER WELL DRILLERS LOG

Date: April 1, 1966, Driller: Burney Water Well Serv. Inc., County: Copiah

(Name)

(1) Owner of Land: Nether Lee Cristy

Rt. 3 Box 91 Crystal Springs, Miss.

(2) Location: 1/4 SE 1/4, Sec. 25, T24N, R34W

6 1/2 miles Southwest of Dentville

(3) Topography: Hilly

(4) Purpose of Well: Domestic

| Description & Kind of Materials Sand, Clay, etc. | Thickness Feet | Depth Feet |
|---|-------------------|---------------|
| Top soil & CODED | 5 | 5 |
| Red sand | 13 | 18 |
| Red sand & gravel | 30 | 48 |
| Pea gravel | 18 | 66 |
| Hard rock | 1 | 67 |
| White clay & rock layers | 17 | 84 |
| Blue shale | 22 | 106 |
| Fine sand in layers | 18 | 124 |
| Rock | 1 | 125 |
| Blue clay & sand layers | 20 | 145 |
| Hard blue shale | 23 | 168 |
| Tight hard gumbo | 14 | 182 |
| Fine sand | 39 | 221 |
| Med to coarse sand | 13 | 234 |
| Fine to med. sand | 12 | 246 |

Information upon completion of well:

(1) Diameter: 4 1/2 inches.

(2) Total Depth: 246 feet.

(3) Water Level: 170 feet below top of ground.

(4) Cased to: 225', Size: 2"


(5) Screen: Size: 2 1/2", Length: 5'

(6) Were any formations sealed against pollution? X yes, no.

If YES depth of formation: From surface to prevent surface pollution

Drillers Remarks: Sanitary well seal used.

CODED

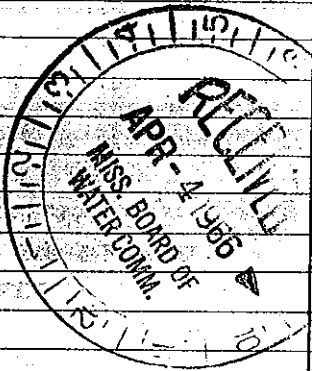

Well No.

(Use Back Side)