

COPIA#
C22
12-15-74
E Log # 218


MISSISSIPPI
BOARD OF WATER COMMISSIONERS
416 North State Street
Jackson, Mississippi 39201

WATER WELL DRILLERS LOG CODED

12/15/74 date well completed 74 R. E. Thompson Copiah firm name Copiah county well located

LANDOWNER:	description of formations encountered	from	to
Jack Anderson Copiah Springs (mailing address)			
WELL LOCATION:	gray clay	5	40
sec. 6 T. 2 N. R. 3 E. S. 1 W.	blue clay	40	70
10 miles NW of Copiah (distance) (direction) (nearest town)	Blue clay	70	140
WELL PURPOSE: (home, irrigation, municipal, industrial)	fine sand	140	160
WELL COMPLETION DATA:	brown clay	160	180
(1) diameter (inches) 4"	sand streak	180	224
(2) total depth (feet) 224			
(3) static water level (feet) 82 below top of ground			
(4) casing (material) (depth) 4" x 2" 15'			
(5) screen (length) (depth to top) 10' @ 5' 184'			
(6) pump (HP) (yield gpm) 2 9			
(7) electric log (yes or no) yes			
(8) how well bottom plugged			
DRILLERS REMARKS:			

CODED

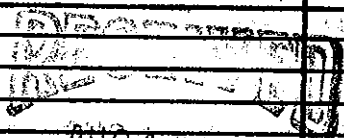

AUG 14 1974

MISS. BD. OF WATER COMM