

**COPIAH MISSISSIPPI BOARD OF WATER COMMISSIONERS**

**D**

**3-25-66**

**WATER WELL DRILLERS LOG**

Date March 25, 1966, Driller: Burnley Water Well Ser., Inc. Copiah County, Mississippi  
(Name)

(1) Owner of Land: Tyrone Y. Sexton  
(Name)  
Crystal Springs  
228 Sidale Street  
(Address)  
(2) Location: 1 miles Nor of Crystal Springs  
(distance) (Nearest Town)  
(3) Topography: Hilly  
(Hilly) (Flat) (Level)  
(4) Purpose of Well: Domestic  
(Domestic Irrigation, Municipal, Industrial, Other)

Description & Color of Materials Sand, Clay, Red Clay, Shell, etc.	Thickness Feet	Depth Feet
Clay & gravel	6	6
Charley grey formation	5	11
Hard formation	2	13
Grey & yellow clay	7	20
Hard grey shale	6	26
Yellow & grey clay	26	52
Blue shale	13	65
Brown & blue clay	5	70
Blue shale	14	84
Blue clay with sand layers	23	107
Blue shale	17	124
All fine sand	8	132
Blue shale	10	142

Information upon completion of well:

(1) Diameter: 6 1/2 inches

(2) Total Depth: 142 feet

(3) Water Level: 74 feet below top of ground

(4) Cased to: 127 feet. Size: 4"

(5) Screen: Size 4" Length 5'


(6) Were any formations sealed against pollution?  
X yes,        no

If YES depth of formation From surface

Why to prevent surface pollution

Drillers Remarks: Sanitary well seal

Used

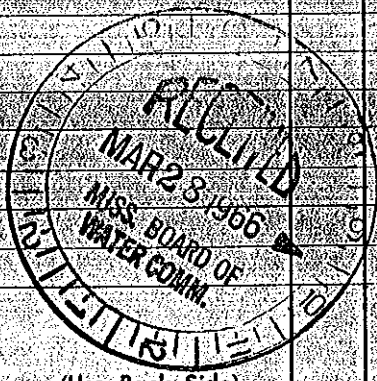

(Use Back Side)

Well No.

Mail this copy to Board of Water Commissioners 429 Miss. St. Jackson, Miss.