

COPIAH MISSISSIPPI BOARD OF WATER COMMISSIONERS

D 9
9-8-65

WATER WELL DRILLERS LOG

Code

Date: Sept. 8, 1965, Driller: Bimney Well Service, Inc County: Copiah

(1) Owner of land: Standard Oil Ser. Sta.
(Name)

Crystal Springs, Miss.
(Address)

(2) Location: Highway 27 West
1 1/4 Sec. T2 R2
1/4 miles North of Crystal Springs
(distance) (direction)

(3) Topography: Hilly
(Hilly) (Flat) (Level)

(4) Purpose of Well: Service Station
(Domestic, Irrigation, Municipal, Industrial, Other)

Information upon completion of well:

(1) Diameter: 6 inches

(2) Total Depth: 222 feet

(3) Water Level: 74 feet below top of ground

(4) Cased to: 1 1/2" Size: 4"

(5) Screen Size: 4" Length: 15'


(6) Were any formations sealed against pollution?
 yes, no

If YES depth of formation: from surface

Why to prevent surface pollution:
cement grout 20' below surface

Drillers Remarks: well seal used

Description & Color of Materials Sand, Clay, Red Clay, Shell, etc.	Thickness Feet	Depth Feet
Red top soil	7	7
Red sand	14	21
White sand	14	35
Pea gravel	13	48
Big clay gravel	2	50
Iron or Sand stone	2	52
Pipe clay	8	60
Sand rock	1	61
Pipe clay	2	63
Blue clay	7	70
Sand layers	11	81
All medium sand	11	92
Sand layers	9	101
Rock	2	103
Blue clay	27	130
All fine sand	23	153
Blue clay	19	172
Fine sand layers	14	186
All fine sand	18	204
Blue shale	18	222

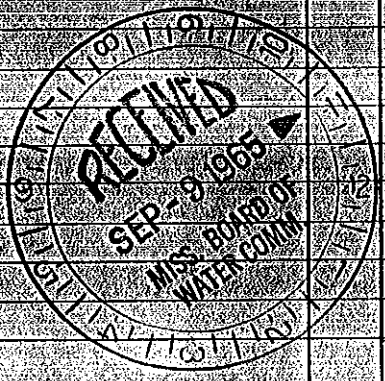

(Use Back Side)

Well No.

Mail this copy to Board of Water Commissioners 429 Miss. St. Jackson, Miss.