

COPIAH MISSISSIPPI BOARD OF WATER COMMISSIONERS

D11
7-29-65

WATER WELL DRILLERS LOG

[Handwritten Signature]

Date: July 29, 1965, Driller: Layne Central Co. County: Copiah

(Name)

Miss. Federated Cooperatives

(1) Owner of Land: (Name)
Crystal Springs, Miss.

(2) Location: 1/4 Sec. 21 N 21 W
35 21 21
miles of (distance) (direction) (Nearest Town)

(3) Topography: (Hilly) (Flat) (Level)

(4) Purpose of Well: ?
(Domestic Irrigation, Municipal, Industrial, Other)

Description & Color of Materials Sand, Clay, Red Clay, Shell, etc.	Thick- ness Feet	Depth Feet
Well No. 3		
clay	8	8
clay gravel	10	18
clay gravel-sand	6	24
coarse sand-pea gravel	62	86
rock	2	88
hard clay	6	94
clay-rock stks	66	160
sandy clay	30	190
sand	10	200
hard shale	47	247

Information upon completion of well:

(1) Diameter: 18 inches.

(2) Total Depth: 86 feet.

(3) Water Level: 24 feet below top of ground.

(4) Cased to: 71' Size: 12"

(5) Screen: Size: 8" Length: 15'


(6) Were any formations sealed against pollution?

yes, no.

If YES depth of formation: 71'

Why: required

Drillers Remarks:

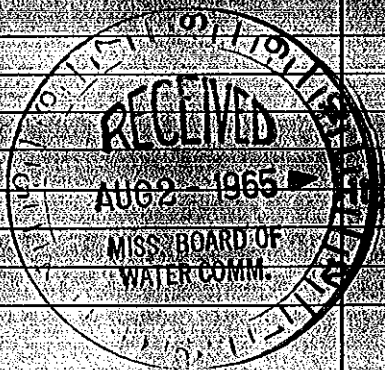

(Use Back Side)

Well No.

Mail this copy to Board of Water Commissioners 429 Miss. St. Jackson, Miss.