

**COPIA MISSISSIPPI BOARD OF WATER COMMISSIONERS**

D/12

7-29-65

**WATER WELL DRILLERS LOG**

*Copied*

Date: July 29, 1965, Driller: Layne-Central Co. County: Osish

(Name)

(1) Owner of Land: Miss. Federated Cooperative  
(Name)

Crystal Springs, Miss.  
(Address)

(2) Location: 1/4 Sec 35, 2N 2W  
(distance) (direction) (Nearest Town)

(3) Topography: (Hilly) (Flat) (Level)

(4) Purpose of Well: ?  
(Domestic, Irrigation, Municipal, Industrial, Other)

| Description & Color of Materials<br>(Sand, Clay, Red Clay, Shell, etc.) | Thick-<br>ness<br>Feet | Depth<br>Feet |
|---|------------------------|---------------|
| Well No. 1  |                        |               |
| red sandy clay  | 12                     | 12            |
| red sand-gravel   | 20                     | 32            |
| clay-gravel   | 12                     | 44            |
| sand-gravel   | 20                     | 64            |
| pea gravel  | 16                     | 80            |
| clay (pink)   | 6                      | 86            |
| sand-pea gravel   | 31                     | 117           |

Information upon completion of well:

(1) Diameter 18 inches

(2) Total Depth 117 feet

(3) Water Level 55 feet below top of ground

(4) Cased to 95' Size 1 1/2"

(5) Screen Size 8" Length 20'


(6) Were any formations sealed against pollution?

yes  no

If YES depth of formation 95'

Why required

Drillers Remarks:

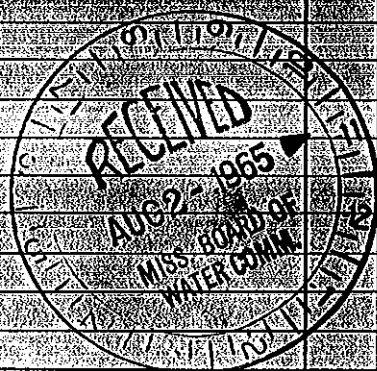

(Use Back Side)

Well No.

Mail this copy to Board of Water Commissioners 429 Miss. St. Jackson, Miss.